

HANCOCK
K 2245
2/17/78

MISSISSIPPI
BOARD OF WATER COMMISSIONERS
416 North State Street
Jackson, Mississippi 39201

WATER WELL DRILLERS LOG

2-17 1928 Ward Well Dlg. Hancock
date well completed firm name county well located

LANDOWNER: Irma Levin
Sunset Dr.
Bay St. Louis miss.
(mailing address)

description of formations encountered	from	to
top Soil - clay	0	21
SD	21	45
dry clay	45	94
SD	94	126
Red gravel - sd	126	260
clay - silt	260	385
SD	385	413

WELL LOCATION:
sec. 42 T-8 N R14 E
1 miles NW of B.S. La.
(distance) (direction) (nearest town)

WELL PURPOSE: Heat Pump
(home, irrigation, municipal, industrial)

- WELL COMPLETION DATA:
- (1) diameter (inches) ~~4~~ 4x2
 - (2) total depth (feet) 413
 - (3) static water level (feet) 9 ^{below} above top of ground.
 - (4) casing PVC, 403.
(material) (depth)
 - (size) If telescope see back.
 - (5) screen 10' -
(length) (depth to top)
 - 2" PVC
(size) (material)
 - (6) pump 1/2 20
(HP) (yield gpm)
 - Elec.
(type power)
 - (7) electric log NO
(yes or no)
 - N/A
(organization running log)
 - (8) how well bottom plugged BWU

DRILLERS REMARKS:
Installed 100 feet 1 1/2" log;
303-2" log.
10 ft. - well screen


RECEIVED

MAR 15 1978

MISS. BD. OF WATER COMM.

If well telescopes please sketch and show depths.

GROUND LEVEL

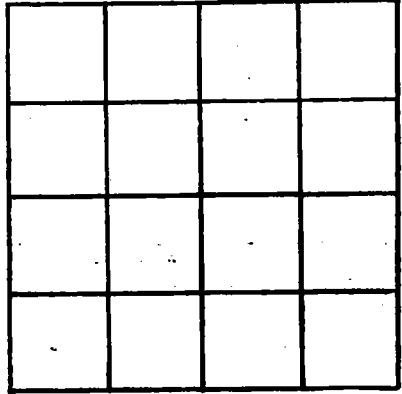

SECTION 42

Please indicate well location X.

ADDITIONAL INFORMATION

If more than one screen, show locations of each on sketch.