

HANCOCK

K 2017

MISSISSIPPI BOARD OF WATER COMMISSIONERS  
416 North State Street  
Jackson, Mississippi 39201

WATER WELL DRILLERS LOG

5-24-1978  
date well completed

ward well dly.  
firm name

Hancock  
county well located

LANDOWNER:

Roy Burkart  
Burkart

Ansley Rd.

Ansley, Miss.  
(mailing address)

description of formations encountered

from to

top Soil-clay

0 22

clay-shell

22 45

clay

45 95

Red gravel - sd

95 110

110 140

140 165

WELL LOCATION:

sec. 19 T 9 N R 14 E  
25 1/2 miles W of B.S.L.  
(distance) (direction) (nearest town)

WELL PURPOSE:

Home  
(home, irrigation, municipal, industrial)

WELL COMPLETION DATA:

- (1) diameter (inches) 2"
- (2) total depth (feet) 165
- (3) static water level (feet) 9 <sup>below</sup> top of ground
- (4) casing PVC 160  
(material) (depth)  
If telescope see back.  
(size)
- (5) screen 5  
(length) (depth to top)  
2" PVC  
(size) (material)
- (6) pump owner  
(HP) (yield gpm)  
(type power)
- (7) electric log no  
(yes or no)  
N/A  
(organization running log)
- (8) how well bottom plugged BWV

DRILLERS REMARKS:

N/A


RECEIVED

JUN 28 1978

MISS. BD. OF WATER COMM

If well telescopes please sketch and show depths.

GROUND LEVEL

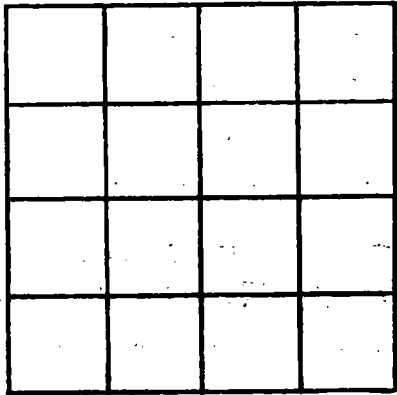

SECTION 19

Please indicate well location X.

ADDITIONAL INFORMATION

A series of horizontal lines providing space for additional information.

If more than one screen, show locations of each on sketch.