

HANCOCK
K 22 48

MISSISSIPPI
BOARD OF WATER COMMISSIONERS
416 North State Street
Jackson, Mississippi 39201

WATER WELL DRILLERS LOG

6-1-1978 date well completed 78 Ward Well Drg. firm name Hancock county well located

LANDOWNER: Charles Olive
7th St. - Bayou Phillip
Bay St. Louis, Miss
(mailing address)

description of formations encountered	from	to
Fill & Clay	0	21
White sd	21	36
Clay	36	91
sd	91	94
Clay Silt	94	230
Coarse sd	230	252

WELL LOCATION:
sec. 30 T 9 N R. 14 E
10 miles W of B.S.L.
(distance) (direction) (nearest town)

WELL PURPOSE: Home
(home, irrigation, municipal, industrial)

WELL COMPLETION DATA:

(1) diameter (inches) 2"

(2) total depth (feet) 252

(3) static water level (feet) 2 below top of ground

(4) casing PVC, 247,
(material) (depth)
- If telescope see back.
(size)

(5) screen 5', -
(length) (depth to top)
2", PVC
(size) (material)

(6) pump owner
(HP) (yield gpm)
- (type power)

(7) electric log no,
(yes or no)
N/A
(organization running log)

(8) how well bottom plugged BWW

RECEIVED


JUL 26 1978

DRILLERS REMARKS: N/A

MISS. BD. OF WATER COMM

If well telescopes please sketch and show depths.

GROUND LEVEL

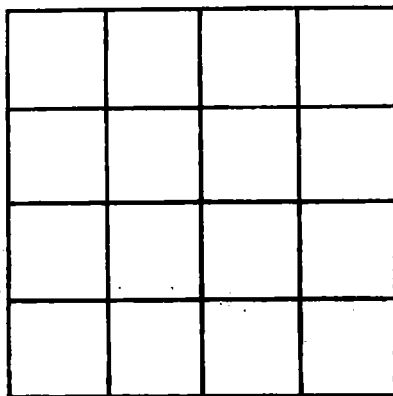

SECTION 30

Please indicate well location X.

ADDITIONAL INFORMATION

If more than one screen, show locations of each on sketch.