

HANCOCK

K 2852

7-9-77

MISSISSIPPI BOARD OF WATER COMMISSIONERS 416 North State Street Jackson, Mississippi 39201

WATER WELL DRILLERS LOG

July 9 1977 Fane well works Hanceville date well completed firm name county well located

LANDOWNER: Mrs Glen Bay field ponds

(mailing address)

WELL LOCATION: sec 33 T 9 N R 14 E W 6 miles W of BSL (distance) (direction) (nearest town)

WELL PURPOSE: Home (home, irrigation, municipal, industrial)

- WELL COMPLETION DATA: (1) diameter (inches) 2 (2) total depth (feet) 140 (3) static water level (feet) 3 below top of ground (4) casing Plastic 140 (material) (depth) 2 (size) If telescope see back. (5) screen 10 140 (length) (depth to top) 2 Plastic (size) (material) (6) pump 1/2 (HP) 20 (yield gpm) G. Smith (type power) (7) electric log (yes or no) (organization running log) (8) how well bottom plugged B.W.V

Table with 3 columns: description of formations encountered, from, to. Rows include: Clay (0-10), sand clay (10-20), sand (20-30), Clay (30-40), Clay & shells (40-50), Clay & shells (50-60), Clay & shells (60-70), clay sand (70-80), sand (80-90), sand clay (90-100), sand (100-110), Clay (110-120), Clay & sand (120-130), sand (Blue) (130-140)


RECEIVED OCT 2 1978

MISS. BD. OF WATER COMM

DRILLERS REMARKS:

If well telescopes please sketch and show depths.

GROUND LEVEL

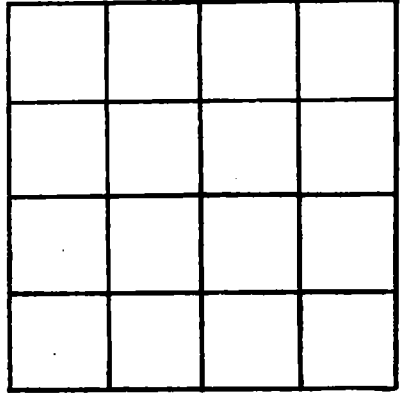

SECTION _____

Please indicate well location X.

ADDITIONAL INFORMATION

If more than one screen, show locations of each on sketch.