

HANCOCK
 K 2054
 7-26-78

MISSISSIPPI
 BOARD OF WATER COMMISSIONERS
 416 North State Street
 Jackson, Mississippi 39201

WATER WELL DRILLERS LOG

7-26-1978 ward well Drg. Hancock
 date well completed firm name county well located

LANDOWNER: Pete Regilone
Gen St.
Bay St. Louis, Miss.
 (mailing address)


description of formations encountered	from	to
Fill-clay	0	18
sd	18	45
clay	45	95
fine sd.	95	110
clay	110	122
med. sd.	122	135

WELL LOCATION:
 sec. 29 T 9 N R 14 E
6 miles n/w of Woodland
 (distance) (direction) (nearest town)

WELL PURPOSE: camp
 (home, irrigation, municipal, industrial)

WELL COMPLETION DATA:
 (1) diameter (inches) 2"
 (2) total depth (feet) 135
 (3) static water level (feet) 3 ^{below} ~~above~~ top of ground.
 (4) casing PVC 130
 (material) (depth)
 — If telescope see back.
 (size)
 (5) screen 5' —
 (length) (depth to top)
2" PVC
 (size) (material)
 (6) pump runner
 (HP) (yield gpm)
 —
 (type power)
 (7) electric log no
 (yes or no)
N/A
 (organization running log)
 (8) how well bottom plugged BWV


DRILLERS REMARKS: N/A

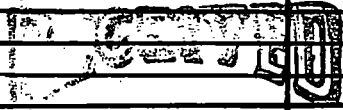

SEP - 5 1978

If well telescopes please sketch and show depths.

GROUND LEVEL

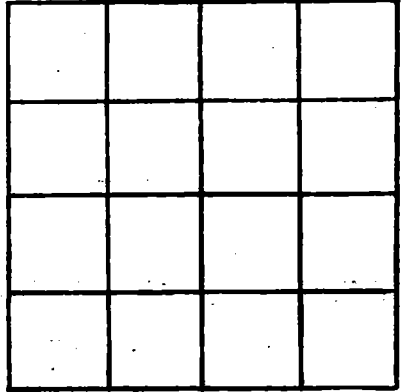

SECTION 29

Please indicate well location X.

ADDITIONAL INFORMATION

If more than one screen, show locations of each on sketch.