

HANCOCK
 K 2256
 7-28-78

MISSISSIPPI
 BOARD OF WATER COMMISSIONERS
 416 North State Street
 Jackson, Mississippi 39201

WATER WELL DRILLERS LOG

7-28 1977 Ward Well Dlg Hancock
 date well completed firm name county well located

LANDOWNER: Ed DiMaggio
East Lincoln
Bay St. Louis, miss.
 (mailing address)

WELL LOCATION:
 sec. 6 T 9 N R. 14 E ?
13 miles S/W of Bay St. Louis
 (distance) (direction) (nearest town)

WELL PURPOSE: Home
 (home, irrigation, municipal, industrial)

WELL COMPLETION DATA:
 (1) diameter (inches) 2"
 (2) total depth (feet) 294
 (3) static water level (feet) 9 below top of ground
 (4) casing PVC 289
 (material) (depth)
 (size) If telescope see back.
 (5) screen 5' -
 (length) (depth to top)
2" PVC
 (size) (material)
 (6) pump owner
 (HP) (yield gpm)
 (type power)
 (7) electric log no
 (yes or no)
N/A
 (organization running log)
 (8) how well bottom plugged BWV

description of formations encountered	from	to
top soil - clay	0	21
sd	21	37
clay - shell	37	96
coarse sd	96	132
clay	132	164
fine gravel - sd	164	168
clay - silt	168	265
fine sd	265	277
coarse sd.	277	294


DRILLERS REMARKS: N/A

RECEIVED
 SEP - 5 1978

MISS. BD. OF WATER COMM

If well telescopes please sketch and show depths.

GROUND LEVEL

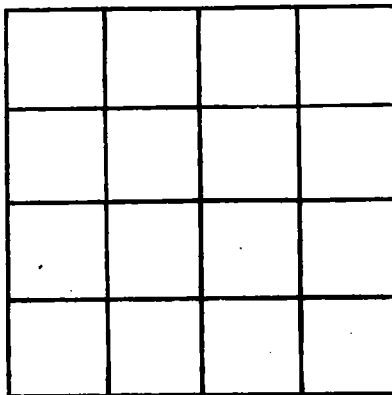

SECTION 6

Please indicate well location X.

ADDITIONAL INFORMATION

If more than one screen, show locations of each on sketch.