

HANCOCK
K 2261
9-8-78

MISSISSIPPI
 BOARD OF WATER COMMISSIONERS
 416 North State Street
 Jackson, Mississippi 39201

WATER WELL DRILLERS LOG

9-8 1978 LECORNU FARMS HANCOCK
 date well completed firm name county well located


LANDOWNER: <u>H.R. LECORNU</u>	description of formations encountered	from	to
<u>Rt 2 Box 666 F</u>			
<u>Bay St Louis ms</u> (mailing address)	<u>CLAY SAND</u>	<u>2</u>	<u>10</u>
<u>WELL LOCATION:</u>	<u>SAND</u>	<u>10</u>	<u>30</u>
sec <u>5</u> T <u>9</u> N <u>5</u> R <u>14</u> E <u>W</u>	<u>CLAY</u>	<u>30</u>	<u>34</u>
<u>3</u> miles <u>West</u> of <u>Waveland</u>	<u>SAND & GRAVEL</u>	<u>34</u>	<u>150</u>
(distance) (direction) (nearest town)			
<u>WELL PURPOSE: Home</u> (home, irrigation, municipal, industrial)			
<u>WELL COMPLETION DATA:</u>			
(1) diameter (inches) <u>4" x 2"</u>			
(2) total depth (feet) <u>150</u>			
(3) static water level (feet) <u>7</u> below above top of ground.			
(4) casing <u>PVC</u> <u>140</u> (material) (depth)			
<u>4 x 2</u> If telescope see back. (size)			
(5) screen <u>10'</u> <u>140</u> (length) (depth to top)			
<u>2"</u> <u>PVC</u> (size) (material)			
(6) pump <u>1/2</u> <u>12</u> (HP) (yield gpm)			
<u>110 VAC</u> (type power)			
(7) electric log <u>NO</u> (yes or no)			
(organization running log)			
(8) how well bottom plugged <u>Sand Shale</u>			
<u>DRILLERS REMARKS:</u>			
<u>Well for own use</u>			
<u>in Mobile Home</u>			

RECEIVED

OCT 4 1978

MISS. BD. OF WATER COMM.

If well telescopes please sketch and show depths.

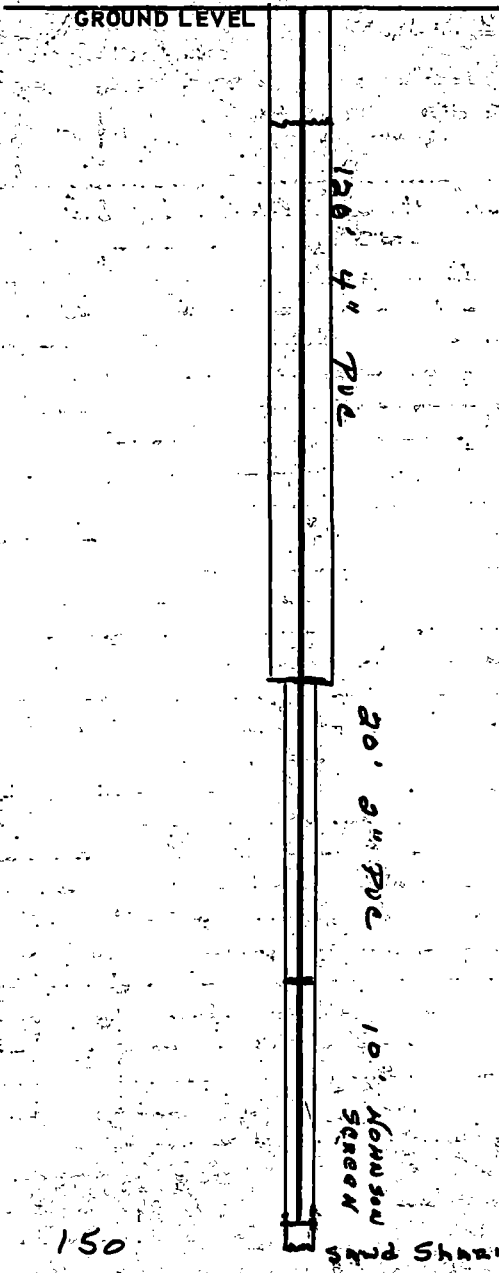

N

X			

SECTION _____

Please indicate well location X.

ADDITIONAL INFORMATION

Well located on

Lot 36

Square 113

Unit 11

Bay Side Park

Malden Co MA

If more than one screen, show locations of each on sketch.