

HANCOCK

K 2262

9-20-78

MISSISSIPPI BOARD OF WATER COMMISSIONERS 416 North State Street Jackson, Mississippi 39201

WATER WELL DRILLERS LOG

9-20 - 1978 date well completed

Ward Well Drg. firm name

Hancock county well located

LANDOWNER: James W. Miller

Hancock Dr. Bay St. Louis, Miss. (mailing address)

description of formations encountered

from to

Top Soil - clay

0 18

sd Heavy mud

18 41

sd

41 76

clay

76 115

Red Shovel - sd

115 148

148 185

WELL LOCATION:

sec. 6 T 9 N R 14 E 14 miles S/W of B.S.L. (distance) (direction) (nearest town)

WELL PURPOSE: Home (home, irrigation, municipal, industrial)

WELL COMPLETION DATA:

- (1) diameter (inches) 2"
(2) total depth (feet) 185
(3) static water level (feet) 10 below top of ground
(4) casing PVC 180 (material) (depth)
(5) screen 5 (length) (depth to top) 2" PVC (size) (material)
(6) pump 1/2 10 (HP) (yield gpm) Elec. (type power)
(7) electric log no (yes or no) N/A (organization running log)
(8) how well bottom plugged BWV


RECEIVED

OCT 30 1978

DRILLERS REMARKS: N/A

If well telescopes please sketch and show depths.

GROUND LEVEL

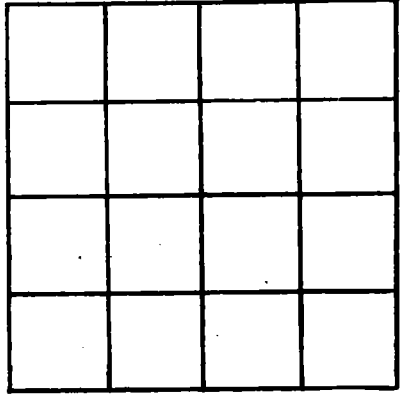

SECTION 6

Please indicate well location X.

ADDITIONAL INFORMATION

If more than one screen, show locations of each on sketch.