

HANGCOCK

K 2763

9-29-78

MISSISSIPPI BOARD OF WATER COMMISSIONERS
416 North State Street
Jackson, Mississippi 39201

WATER WELL DRILLERS LOG

9-29

1978 Ward Well Dlg.

Itanoch

date well completed

firm name

county well located

LANDOWNER: Planere mfg.

Pt. 3, Box 35c

Bay St. Louis, miss
(mailing address)

description of formations encountered

clay - fill

from

to

0 21

21 45

45 62

62 85

85 105

105 114

114 152

152 178

WELL LOCATION:

sec. 28 T 9 N R 14 E

6 miles N/W of B.S.L.
(distance) (direction) (nearest town)

WELL PURPOSE: Home-Business
(home, irrigation, municipal, industrial)

WELL COMPLETION DATA:

- (1) diameter (inches) 2"
- (2) total depth (feet) 178
- (3) static water level (feet) 5 ^{below} top of ground

- (4) casing PVC 173
(material) (depth)

— If telescope see back.
(size)

- (5) screen 5' —
(length) (depth to top)
- 2" PVC
(size) (material)

- (6) pump crane —
(HP) (yield gpm)
- (type power)

- (7) electric log no
(yes or no)
- N/A
(organization running log)

- (8) how well bottom plugged BWV


DRILLERS REMARKS: N/A

RECEIVED
OCT 30 1978

MISS. BD. OF WATER COMM

If well telescopes please sketch and show depths.

GROUND LEVEL

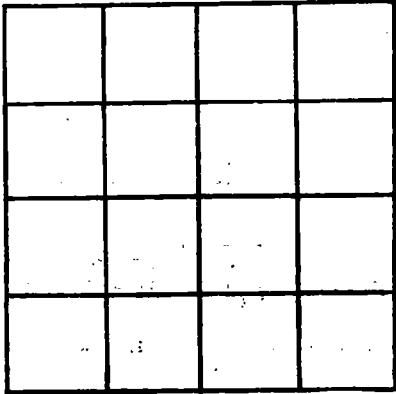

SECTION 28

Please indicate well location X.

ADDITIONAL INFORMATION

If more than one screen, show locations of each on sketch.