

HANCOCK  
K 2269  
11-18-78

MISSISSIPPI  
BOARD OF WATER COMMISSIONERS  
416 North State Street  
Jackson, Mississippi 39201

WATER WELL DRILLERS LOG

11-18 1978 WARD WELL DLG. HANCOCK  
date well completed firm name county well located

LANDOWNER: FRANK KOOPMAN  
Rameneda St.  
Bay St. Louis, Miss.  
(mailing address)

WELL LOCATION:  
sec 3 T 8 N R 14 E  
2 miles SSW of B.S.L.  
(distance) (direction) (nearest town)

description of formations encountered	from	to
clay - top soil	0	18
SC	18	25
clay	25	46
SC	46	54
clay	54	82
Course PSD	82	110

WELL PURPOSE: Heat Pump  
(home, irrigation, municipal, industrial)

WELL COMPLETION DATA:

(1) diameter (inches) 4"

(2) total depth (feet) 108-110'

(3) static water level (feet) 10' <sup>below</sup> above top of ground.

(4) casing PVC 98-100  
(material) (depth)

— If telescope see back.  
(size) —

(5) screen 10' —  
(length) (depth to top)

4" — PVC  
(size) (material)

(6) pump — —  
(HP) (yield gpm)

—  
(type power)

(7) electric log NO  
(yes or no)

NT  
(organization running log)


(8) how well bottom plugged BWV

DRILLERS REMARKS: These wells were drilled for heat pump use only.

RECEIVED  
DEC 21 1978  
MISS. BD. OF WATER COMMISSIONERS

If well telescopes please sketch and show depths.

GROUND LEVEL

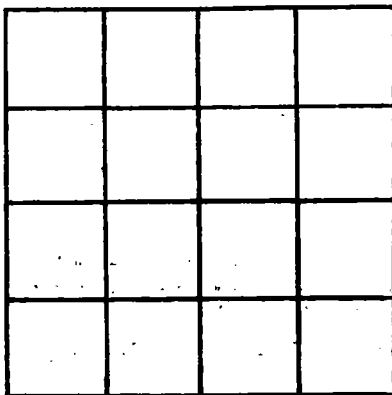

SECTION 3

Please indicate well location X.

ADDITIONAL INFORMATION

If more than one screen, show locations of each on sketch.