

HANCOCK
 K 2270
 12-05-78

MISSISSIPPI
 BOARD OF WATER COMMISSIONERS
 416 North State Street
 Jackson, Mississippi 39201

WATER WELL DRILLERS LOG

12-5-1978 date well completed 28 Woodwell Drilling firm name Hancock county well located

LANDOWNER: Eugene McCarroll
 Lakeshore Rd
 Bay St. Louis, Miss.
 (mailing address)


WELL LOCATION:
 sec. 24 T 9 N R 15 E
 18 miles S/W of B.S. L
 (distance) (direction) (nearest town)

WELL PURPOSE: Home
 (home, irrigation, municipal, industrial)

- WELL COMPLETION DATA:
- (1) diameter (inches) 2"
 - (2) total depth (feet) 356
 - (3) static water level (feet) 2 ^{below} _{above} top of ground ^{flow}
 - (4) casing PVC, 346 (material) (depth)
 - (size) if telescope see back.
 - (5) screen 10' (length) (depth to top)
 2" PVC (size) (material)
 - (6) pump owner (HP) (yield gpm)
 (type power)
 - (7) electric log NO (yes or no)
 N/A (organization running log)
 - (8) how well bottom plugged BwV

description of formations encountered	from	to
mud-clay	0	35
sd	35	56
clay-shell	56	105
Red gravel-sd	105	126
clay-silt	126	220
vsd	220	226
clay-silt	226	320
coarse sd	320	356

DRILLERS REMARKS: N/A

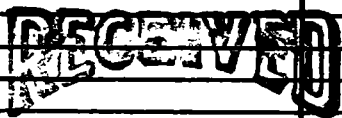


JAN 17 1978

MISS. BD. OF WATER COMM

If well telescopes please sketch and show depths.

GROUND LEVEL

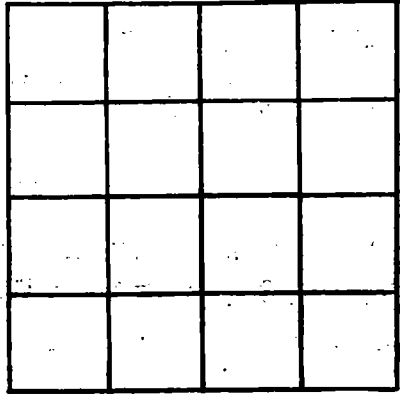

SECTION 24

Please indicate well location X.

ADDITIONAL INFORMATION

If more than one screen, show locations of each on sketch.