

HANCOCK
 K 2272
 12-07-78

MISSISSIPPI
 BOARD OF WATER COMMISSIONERS
 416 North State Street
 Jackson, Mississippi 39201

WATER WELL DRILLERS LOG

12-7 date well completed 78 Ward Well Dlg. firm name Hancock county well located

LANDOWNER: Louis Asker
Rt. 4, Box 386
Bay St. Louis, Miss.
 (mailing address)

description of formations encountered	from to	
<u>Top Soil-clay</u>	<u>0</u>	<u>15</u>
<u>SC</u>	<u>15</u>	<u>35</u>
<u>Clay</u>	<u>35</u>	<u>92</u>
<u>SC</u>	<u>92</u>	<u>108</u>

WELL LOCATION:
 sec. 34 9 N R. 14 E
8 miles W of B.S.L.
 (distance) (direction) (nearest town)

WELL PURPOSE: Home
 (home, irrigation, municipal, industrial)

- WELL COMPLETION DATA:
- (1) diameter (inches) 2"
 - (2) total depth (feet) 108
 - (3) static water level (feet) 4 ^{below} _{above} top of ground
 - (4) casing PVC, 98,
 (material) (depth)
 (size) If telescope see back.
 - (5) screen 10' -
 (length) (depth to top)
2" PVC
 (size) (material)
 - (6) pump owner
 (HP) (yield gpm)
 (type power)
 - (7) electric log NO
 (yes or no)
N/A
 (organization running log)
 - (8) how well bottom plugged BWU

DRILLERS REMARKS:


RECEIVED

JAN 17 1978

MISS. BD. OF WATER COMM

If well telescopes please
sketch and show depths.

GROUND LEVEL

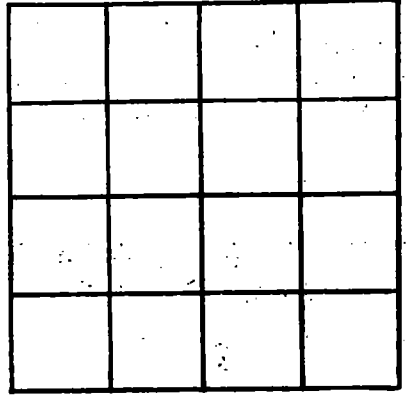

SECTION 36

Please indicate well location X.

ADDITIONAL INFORMATION

Multiple horizontal lines for providing additional information.

If more than one screen,
show locations of each on sketch.