

HANCOCK
K 2784
06-06-79

MISSISSIPPI
BOARD OF WATER COMMISSIONERS
416 North State Street
Jackson, Mississippi 39201

WATER WELL DRILLERS LOG

June 6 1979 Duncan Well Drilling Hancock
date well completed firm name county well located

LANDOWNER: <u>E. R. Phillips</u>	description of formations encountered	from	to
<u>6842 Avenir Rte #1</u> <u>Bay St. Louis, Miss.</u> (mailing address)			
	<u>Clay</u>	<u>0</u>	<u>20</u>
	<u>Sand</u>	<u>20</u>	<u>80</u>

WELL LOCATION:
sec 8 T 8 N R 14 E
12 miles N of Bay St. Louis
(distance) (direction) (nearest town)

WELL PURPOSE: test pump
(home, irrigation, municipal, industrial)

- WELL COMPLETION DATA:
- (1) diameter (inches) 2"
 - (2) total depth (feet) 80 ft
 - (3) static water level (feet) 10' ^{below} above top of ground.
 - (4) casing PVC 70'
(material) (depth)
 - if telescope see back.
(size)
 - (5) screen 10' 70'
(length) (depth to top)
 - 2" PVC
(size) (material)
 - (6) pump _____ (HP) _____ (yield gpm)
 - (type power)
 - (7) electric log _____ (yes or no)
 - (organization running log)
 - (8) how well bottom ugged Sand

DRILLERS REMARKS: _____


DEPT. OF NATURAL RESOURCES
BUREAU OF LAND & WATER RESOURCES

JAN 15 1980

RECEIVED

If well telescopes please sketch and show depths.

GROUND LEVEL

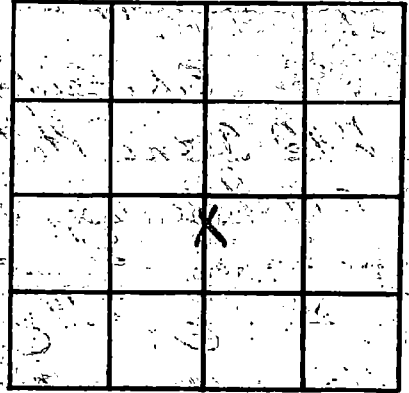

SECTION 8

Please indicate well location X.

ADDITIONAL INFORMATION

If more than one screen, show locations of each on sketch.