

HANCOCK
K 2287
6/28/79

MISSISSIPPI
BOARD OF WATER COMMISSIONERS
416 North State Street
Jackson, Mississippi 39201
WATER WELL DRILLERS LOG

June 28 1979 Braden Pump + Well Hancock
date well completed firm name county well located
service, INC.

LANDOWNER: Arthur Morrison
E Pike Street - Bossie Park
Bay St. Louis, Miss.
(mailing address)

WELL LOCATION:
sec. 6 T. 9 S. R. 14 W.
1 miles W of Hurdlehead
(distance) (direction) (nearest town)

WELL PURPOSE: Home
(home, irrigation, municipal, industrial)

WELL COMPLETION DATA:
(1) diameter (inches) 2" x 4"
(2) total depth (feet) 170
(3) static water level (feet) 20 below
top of ground.
(4) casing PVC 160
(material) (depth)
4" x 2" if telescope see back.
(size)
(5) screen 16 ft 160
(length) (depth to top)
2" .007 Underberg PVC
(size) (material)
(6) pump 1/2 Subm 20
(HP) (yield gpm)
115 Volt
(type power)
(7) electric log No
(yes or no)
(organization running log)

description of formations encountered	from	to
Surface	0	4
Clay	4	16
Sand	16	60
Bay Clay	60	94
Sand	94	120
Blue Clay	120	139
Coarse Sand	139	180
		+

(8) how well bottom plugged
24 Sand Shell
DRILLERS REMARKS:

Miss. Board of Water Comm.

JUL 30 1979

RECEIVED

If well telescopes please sketch and show depths.

GROUND LEVEL

4" sch 40 PVC

120 ft


2" sch 40 PVC

160 ft

2" x 10 ft screen

170 ft

2" sand shark

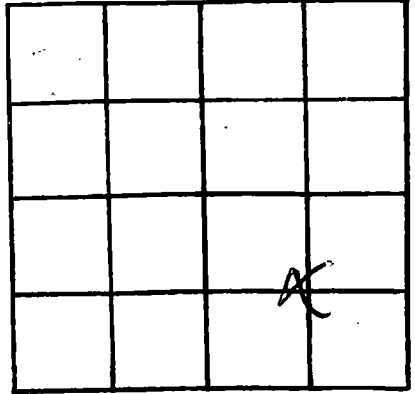

SECTION 6

Please indicate well location X.

ADDITIONAL INFORMATION

If more than one screen, show locations of each on sketch.