

HANCOCK
K 2795
10-23-79

MISSISSIPPI
BOARD OF WATER COMMISSIONERS
416 North State Street
Jackson, Mississippi 39201

WATER WELL DRILLERS LOG

Oct. 23 1979 date well completed
Duncan Well Drilling firm name
Hancock county well located

LANDOWNER: Euden Buezo
Henderson & Scott
Box St. Louis, Miss.
(mailing address)

description of formations encountered	from	to
sand	0	15
clay	15	105
fine sand	105	125
coarse sand	125	145

WELL LOCATION:
sec. 8 T 9 N R 13 E 14 S
4 miles SW of Cleveland
(distance) (direction) (nearest town)

WELL PURPOSE: Home
(home, irrigation, municipal, industrial)

- WELL COMPLETION DATA:
- (1) diameter (inches) 2"
 - (2) total depth (feet) 145 ft
 - (3) static water level (feet) 8' below top of ground
 - (4) casing PVC, 135' (material) (depth)
 - (5) screen 10', 135' (length) (depth to top)
 - 2" PVC (size) (material)
 - (6) pump (HP) (yield gpm)
 - (type power)
 - (7) electric log (yes or no)
 - (organization running log)

(8) how well bottom plugged Sand
Shank

DRILLERS REMARKS: Owner
had his own
pump


DEPT. OF NATURAL RESOURCES
BUREAU OF LAND & WATER RESOURCES

JAN 15 1980

RECEIVED

If well telescopes please sketch and show depths.

GROUND LEVEL

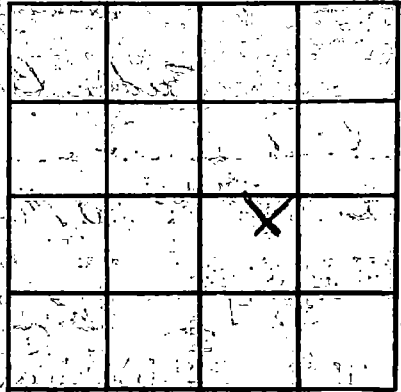

SECTION 8

Please indicate well location X.

ADDITIONAL INFORMATION

If more than one screen, show locations of each on sketch.