

Hancock

K 2314

5-15-80

5-15

1980

Woodwell Dlg.

Hancock

date well completed

firm name

county well located

MISSISSIPPI
 BOARD OF WATER COMMISSIONERS
 416 North State Street
 Jackson, Mississippi 39201

WATER WELL DRILLERS LOG

LANDOWNER: Sunny Harrel
Renn. St.
Bay St. Louis, ms.
 (mailing/address)

description of formations encountered	from	to
fill-clay	0	18
sd	18	45
clay	45	96
fine sd	96	110
silt-clay	110	345
med. coarse sd	345	375

WELL LOCATION:
 sec. 40 T. 8 N R. 14 E
 (distance) (direction) (nearest town)
10 miles NW of B.S.L.

WELL PURPOSE: Home
 (home, irrigation, municipal, industrial)


- WELL COMPLETION DATA:
- (1) diameter (inches) 2"
 - (2) total depth (feet) 375
 - (3) static water level (feet) 1 below top of ground. above
 - (4) casing PVC, 365.
 (material) (depth)
- If telescope see back.
 (size)
 - (5) screen 10, -
 (length) (depth to top)
2", PVC
 (size) (material)
 - (6) pump 1/2, 10
 (HP) (yield gpm)
Elec.
 (type power)
 - (7) electric log NO
 (yes or no)
N/A
 (organization running log)
 - (8) how well bottom plugged BWU

DRILLERS REMARKS: well located in shoreline back side.

DEPT. OF NATURAL RESOURCES
 BUREAU OF LAND & WATER RESOURCES
 JUL - 2 1980
 RECEIVED

If well telescopes please sketch and show depths.

GROUND LEVEL

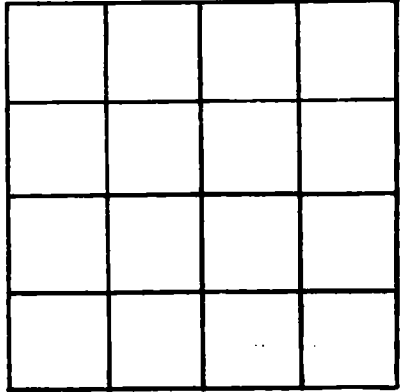

SECTION 40

Please indicate well location X.

ADDITIONAL INFORMATION

If more than one screen, show locations of each on sketch.