

HANCOCK

K 2315
5-19-80

MISSISSIPPI
BOARD OF WATER COMMISSIONERS
416 North State Street
Jackson, Mississippi 39201

WATER WELL DRILLERS LOG

5-19 1980 Ward Well Dlg. Hancock
date well completed firm name county well located

LANDOWNER: John Sange
Sewer Bay Rd.
Bay St. Louis, Mo.
(mailing address)

description of formations encountered	from	to
Top Soil - clay	0	21
clay - shell	21	50
Red gravel - sd	50	98
Shell - clay	98	126
fine sd	126	210
Shell - clay	210	217
Red gravel - sd	217	294
	294	336

WELL LOCATION:
sec. 8 T. 9 N R. 14 E
17 miles S/W of B.S. Mo.
(distance) (direction) (nearest town)

WELL PURPOSE: Home
(home, irrigation, municipal, industrial)


- WELL COMPLETION DATA:
- (1) diameter (inches) 2"
 - (2) total depth (feet) 336
 - (3) static water level (feet) 10 ^{below} top of ground
 - (4) casing PVC, 326 (material) (depth)
 - (size) - If telescope see back.
 - (5) screen 10 (length) (depth to top)
 - 2" PVC (size) (material)
 - (6) pump 1/2 (HP) 10 (yield gpm)
 - Elec. (type power)
 - (7) electric log NO (yes or no)
 - N/A (organization running log)
 - (8) how well bottom plugged BWU

DRILLERS REMARKS: N/A

DEPT. OF NATURAL RESOURCES
BUREAU OF LAND & WATER RESOURCES
RECEIVED JUL - 2 1980

If well telescopes please sketch and show depths.

GROUND LEVEL

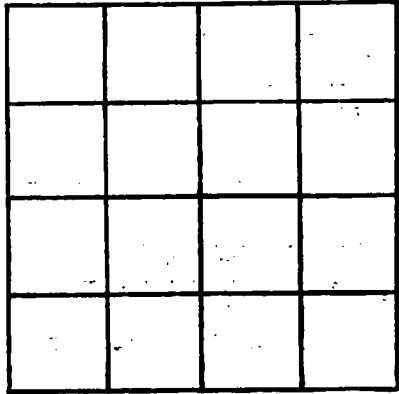

SECTION 8

Please indicate well location X.

ADDITIONAL INFORMATION

A series of horizontal lines for providing additional information.

If more than one screen, show locations of each on sketch.