

MISSISSIPPI DEPARTMENT OF NATURAL RESOURCES
Bureau of Land and Water Resources
 Southport Mall
 P.O. Box 10631
 Jackson, Mississippi 39209
WATER WELL DRILLERS LOG

HANCOCK
K 2329
9-28-80

9-28- 19 80 WARD WELL DRILLING HANCOCK
 date well completed firm name county well located

LANDOWNER: M.H. DODSON
LOWER BAY Rd
BAY ST. LOUIS, MS.
 (mailing address)
 WELL LOCATION:
 sec. 9 T. 9 N. R. 14 E
2 miles W of Waveland
 (distance) (direction) (nearest town)

| description of formations encountered | from | to |
|---------------------------------------|------------|------------|
| <u>Top Soil - clay</u> | <u>0</u> | <u>21</u> |
| <u>Sc</u> | <u>21</u> | <u>40</u> |
| <u>clay</u> | <u>40</u> | <u>82</u> |
| <u>Clay - shell</u> | <u>82</u> | <u>101</u> |
| <u>Red Shale - Sd</u> | <u>101</u> | <u>115</u> |
| <u>clay - silt</u> | <u>105</u> | <u>263</u> |
| <u>Coarse Sd</u> | <u>263</u> | <u>292</u> |

WELL PURPOSE: HOME
 (home, irrigation, municipal, industrial)

WELL COMPLETION DATA:
 (1) diameter (inches) 2"
 (2) total depth (feet) 292
 (3) static water level (feet) 8 below above top of ground.
 (4) casing PVC 282
 (material) (depth)
- If telescope see back.
 (size)
 (5) screen 10' -
 (length) (depth to top)
2" PVC
 (size) (material)
 (6) pump owner -
 (HP) (yield gpm)
-
 (type power)
 (7) electric log NO
 (yes or no)
N/A
 (organization running log)
 (8) how well bottom plugged BWU

DRILLERS REMARKS: N/A


DEPT. OF NATURAL RESOURCES
 BUREAU OF LAND & WATER RESOURCES

NOV - 8 1980

RECEIVED

If well telescopes please sketch and show depths.

GROUND LEVEL

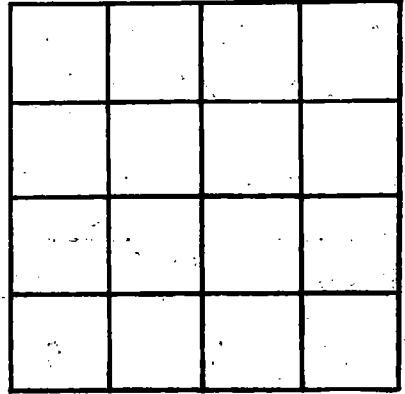

SECTION 9

Please indicate well location X.

ADDITIONAL INFORMATION

If more than one screen,
show locations of each on sketch.