

MISSISSIPPI DEPARTMENT OF NATURAL RESOURCES
Bureau of Land and Water Resources
 Southport Mall
 P.O. Box 10631
 Jackson, Mississippi 39209
WATER WELL DRILLERS LOG

HANCOCK
K 2330
9-29-80

9-29 1980 WARD WELL DLG. HANCOCK
 date well completed firm name county well located

LANDOWNER: <u>B.R. TELL</u>	description of formations encountered	from	to
<u>JEFF DAVIS DRIVE</u>			
<u>BAY ST. LOUIS, MS.</u> (mailing address)	<u>top soil - clay</u>	<u>0</u>	<u>16</u>
<u>WELL LOCATION:</u>	<u>sd</u>	<u>16</u>	<u>38</u>
sec. <u>6</u> T- <u>9</u> N R- <u>14</u> E	<u>clay</u>	<u>38</u>	<u>72</u>
<u>4</u> miles <u>W</u> of <u>Waveland</u>	<u>clay - shell</u>	<u>72</u>	<u>97</u>
(distance) (direction) (nearest town)	<u>sd</u>	<u>97</u>	<u>132</u>
<u>WELL PURPOSE: HOME</u> (home, irrigation, municipal, industrial)	<u>clay - silt</u>	<u>132</u>	<u>148</u>
<u>WELL COMPLETION DATA:</u>	<u>Red gravel - sd</u>	<u>148</u>	<u>165</u>
(1) diameter (inches) <u>2"</u>			
(2) total depth (feet) <u>165</u>			
(3) static water level (feet) <u>10</u> <u>below</u> above top of ground.			
(4) casing <u>PVC</u> <u>155</u> (material) (depth)			
<u>-</u> If telescope see back. (size)			
(5) screen <u>10'</u> <u>-</u> (length) (depth to top)			
<u>2"</u> <u>PVC</u> (size) (material)			
(6) pump <u>cranes</u> <u>-</u> (HP) (yield gpm)			
<u>-</u> (type power)			
(7) electric log <u>NO</u> (yes or no)			
<u>N/A</u> (organization running log)			
(8) how well bottom plugged <u>BWU</u>			

DRILLERS REMARKS: N/A


DEPT. OF NATURAL RESOURCES
 BUREAU OF LAND & WATER RESOURCES

NOV - 3 1980

RECEIVED

If well telescopes please sketch and show depths.

GROUND LEVEL

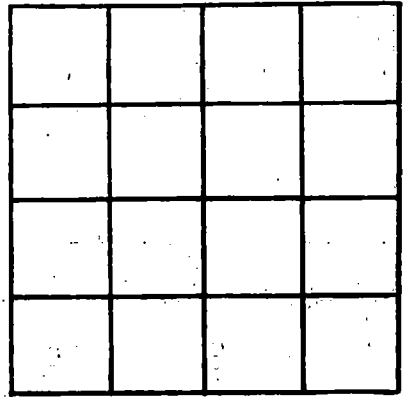

SECTION 6

Please indicate well location X.

ADDITIONAL INFORMATION

If more than one screen,
show locations of each on sketch.