

MISSISSIPPI DEPARTMENT OF NATURAL RESOURCES

Bureau of Land and Water Resources

Southport Mall

P.O. Box 10631

Jackson, Mississippi 39209

WATER WELL DRILLERS LOG

HANCOCK
R 2332
11-3-80

11-3-
date well completed

1980 WARD WELL DRG
firm name

HANCOCK
county well located

LANDOWNER: JOHN W. BORDAGES
P.O. BOX 157
LAKE SHORE, MS.
(mailing address)

WELL LOCATION:
sec. 13 T-9 N R-14 E
0 miles S/W of Lakeshore
(distance) (direction) (nearest town)

WELL PURPOSE: HOME
(home, irrigation, municipal, industrial)

WELL COMPLETION DATA:

(1) diameter (inches) 2"

(2) total depth (feet) 336

(3) static water level (feet) 10 below above top of ground.

(4) casing PVC 326
(material) (depth)

- if telescope see back.
(size)

(5) screen 10' -
(length) (depth to top)

2" PVC
(size) (material)

(6) pump owner -
(HP) (yield gpm)

-
(type power)

(7) electric log NO
(yes or no)

N/A
(organization running log)

(8) how well bottom plugged BWV

description of formations encountered	from	to
Top Soil - clay	0	20
Sd	20	42
clay - shell	42	96
Red Gravel - Sd	96	120
Clay - Silt	120	294
med. coarse Sd	294	336

DRILLERS REMARKS: N/A


DEPT. OF NATURAL RESOURCES
BUREAU OF LAND & WATER RESOURCES

DEC 15 1980

RECEIVED

If well telescopes please sketch and show depths.

GROUND LEVEL

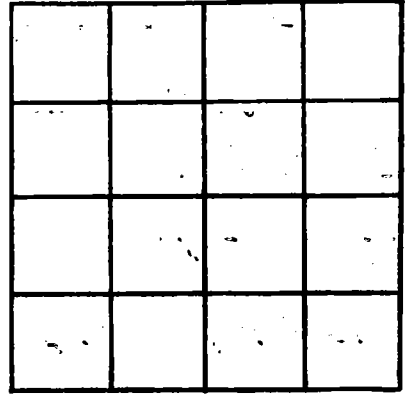

SECTION 13

Please indicate well location X.

ADDITIONAL INFORMATION

If more than one screen,
show locations of each on sketch.