

MISSISSIPPI DEPARTMENT OF NATURAL RESOURCES

Bureau of Land and Water Resources

Southport Mall

P.O. Box 10631

4

Jackson, Mississippi 39209

WATER WELL DRILLERS LOG

HANCOCK  
K 2334  
12-3-80

12-3- 1980 Wood Well Drilling Hancock  
date well completed firm name county well located

LANDOWNER: Hank Bauer  
River Drive  
Bay St. Louis, Miss  
(mailing address)

description of formations encountered	from	to
<u>Fill - clay</u>	<u>0</u>	<u>16</u>
<u>sd</u>	<u>16</u>	<u>42</u>
<u>Clay - silt</u>	<u>42</u>	<u>95</u>
<u>fine sd.</u>	<u>95</u>	<u>115</u>
<u>clay - silt</u>	<u>115</u>	<u>148</u>
<u>med. coarse sd</u>	<u>148</u>	<u>162</u>

WELL LOCATION:  
sec. 39 T. 8 N R. 14 E  
6 miles N of Waveland  
(distance) (direction) (nearest town)

WELL PURPOSE: Home  
(home, irrigation, municipal, industrial)

- WELL COMPLETION DATA:
- (1) diameter (inches) 2"
  - (2) total depth (feet) 162
  - (3) static water level (feet) 3 <sup>below</sup> <sub>above</sub> top of ground.
  - (4) casing PVC, 152,  
(material) (depth)
  - (size) If telescope see back.
  - (5) screen 10', 152  
(length) (depth to top)
  - 2", PVC  
(size) (material)
  - (6) pump 1/2, 10  
(HP) (yield gpm)
  - Elec.  
(type power)
  - (7) electric log NO  
(yes or no)  
N/A  
(organization running log)
  - (8) how well bottom plugged BWU

DRILLERS REMARKS: N/A


DEPT. OF NATURAL RESOURCES  
BUREAU OF LAND & WATER RESOURCES

JAN 15 1981

RECEIVED

If well telescopes please sketch and show depths.

GROUND LEVEL

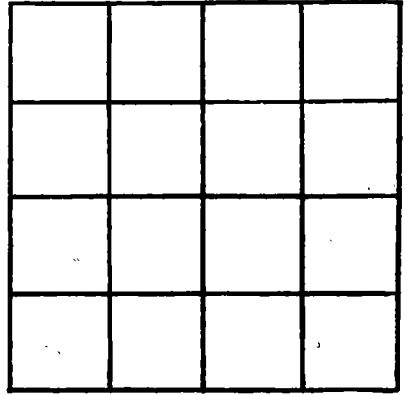

SECTION 39

Please indicate well location X.

ADDITIONAL INFORMATION

If more than one screen, show locations of each on sketch.