

MISSISSIPPI DEPARTMENT OF NATURAL RESOURCES

Bureau of Land and Water Resources

Southport Mall

P.O. Box 10631

Jackson, Mississippi 39209

WATER WELL DRILLERS LOG

HANDECK
K 2335
12-8-80

12-8-
date well completed

80 Wardwell Drilling
firm name

Hancock
county well located

LANDOWNER: Floyd Parta
Spanner Street
Bay St. Louis, ms.
(mailing address)

description of formations encountered	from	to
<u>fill - clay</u>	<u>0</u>	<u>15</u>
<u>sd</u>	<u>15</u>	<u>45</u>
<u>clay - silt</u>	<u>45</u>	<u>76</u>
<u>sd</u>	<u>76</u>	<u>88</u>
<u>clay</u>	<u>88</u>	<u>97</u>
<u>fine sd</u>	<u>97</u>	<u>112</u>
<u>clay</u>	<u>112</u>	<u>124</u>
<u>med coarse sd</u>	<u>124</u>	<u>140</u>

WELL LOCATION:
sec. 28 T. 8 N. R. 14 E. S. 1 W.
8 miles (distance) N of Waveland (nearest town)

WELL PURPOSE: Home
(home, irrigation, municipal, industrial)

- WELL COMPLETION DATA:
- (1) diameter (inches) 2"
 - (2) total depth (feet) 140
 - (3) static water level (feet) 2 below above top of ground.
 - (4) casing PVC, 130,
(material) (depth)
(size) If telescope see back.
 - (5) screen 10', 130
(length) (depth to top)
2", PVC
(size) (material)
 - (6) pump none -
(HP) (yield gpm)
(type power)
 - (7) electric log no
(yes or no)
N/A
(organization running log)
 - (8) how well bottom plugged BWV

DRILLERS REMARKS: N/A


DEPT. OF NATURAL RESOURCES
BUREAU OF LAND & WATER RESOURCES

JAN 15 1981

RECEIVED

If well telescopes please sketch and show depths.

GROUND LEVEL

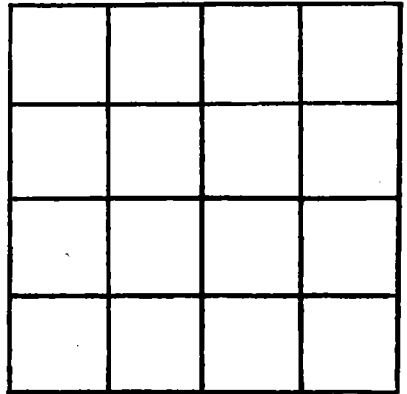

SECTION 28

Please indicate well location X.

ADDITIONAL INFORMATION

If more than one screen, show locations of each on sketch.