

MISSISSIPPI DEPARTMENT OF NATURAL RESOURCES

Bureau of Land and Water Resources

Southport Mall

P.O. Box 10631

Jackson, Mississippi 39209

WATER WELL DRILLERS LOG

~~\_\_\_\_\_~~  
Hancock  
K 2339  
1-17-81

1-13 1981 WARD WELL DRG. Hancock  
 date well completed firm name county well located

LANDOWNER:	description of formations encountered	from	to
<u>Rete Ellis</u>	<u>Top Soil - Clay</u>	<u>0</u>	<u>18</u>
<u> Hwy 603</u>	<u>sd</u>	<u>18</u>	<u>42</u>
<u>Waveland, ms.</u>	<u>Clay</u>	<u>42</u>	<u>80</u>
(mailing address)	<u>sd</u>	<u>80</u>	<u>102</u>
WELL LOCATION:	<u>Clay</u>	<u>102</u>	<u>148</u>
sec. <u>34</u> T <u>9</u> N R. <u>14</u> E	<u>Red gravel - sd</u>	<u>148</u>	<u>167</u>
<u>5</u> miles <u>N</u> of <u>Waveland</u>			
(distance) (direction) (nearest town)			
WELL PURPOSE: <u>Home</u>			
(home, irrigation, municipal, industrial)			
WELL COMPLETION DATA:			
(1) diameter (inches) <u>2"</u>			
(2) total depth (feet) <u>167</u>			
(3) static water level (feet) <u>10</u> <u>below</u> top of ground.			
(4) casing <u>PVC</u> , <u>157</u> , (material) (depth)			
(size) if telescope see back.			
(5) screen <u>10'</u> , (length) (depth to top)			
<u>2"</u> , <u>PVC</u> (size) (material)			
(6) pump <u>owner</u> (HP) (yield gpm)			
(type power)			
(7) electric log <u>NO</u> (yes or no)			
<u>N/A</u> (organization running log)			
(8) how well bottom plugged <u>BWV</u>			
DRILLERS REMARKS: <u>N/A</u>			


DEPT. OF NAT. RESOURCES  
 BUREAU OF LAND & WATER

FEB 12 1981

RECEIVED

If well telescopes please sketch and show depths.

GROUND LEVEL

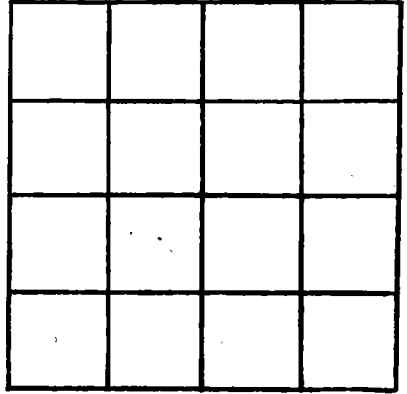

SECTION 34

Please indicate well location X.

ADDITIONAL INFORMATION

If more than one screen, show locations of each on sketch.