

MISSISSIPPI DEPARTMENT OF NATURAL RESOURCES

Bureau of Land and Water Resources

Southport Mall

P.O. Box 10631

3

Jackson, Mississippi 39209

WATER WELL DRILLERS LOG

Hancock
K 23 40
1/15/81

1-15-1981 date well completed

81 WARD WELL DRILLING - HANCOCKS firm name

county well located

LANDOWNER: CLEW BRISTER
SKY LINE DRIVE
BAY ST. LOUIS, MS.
(mailing address)

WELL LOCATION:
sec. 27 T 8 N R 14 E
7 miles N/W of B.S.L.
(distance) (direction) (nearest town)

WELL PURPOSE: HOME
(home, irrigation, municipal, industrial)

WELL COMPLETION DATA:

- (1) diameter (inches) 2"
- (2) total depth (feet) 546
- (3) static water level (feet) 5 below top of ground. above
- (4) casing PVC 536
(material) (depth)
- If telescope see back.
(size)
- (5) screen 10' -
(length) (depth to top)
2" PVC
(size) (material)
- (6) pump owner
(HP) (yield gpm)
-
(type power)
- (7) electric log NO
(yes or no)
N/A
(organization running log)
- (8) how well bottom plugged BWU

description of formations encountered	from	to
<u>fill - clay</u>	<u>0</u>	<u>15</u>
<u>sd</u>	<u>15</u>	<u>45</u>
<u>clay</u>	<u>45</u>	<u>96</u>
<u>fine sd</u>	<u>96</u>	<u>115</u>
<u>clay - silt</u>	<u>115</u>	<u>162</u>
<u>fine sd</u>	<u>162</u>	<u>176</u>
<u>clay - silt</u>	<u>176</u>	<u>250</u>
<u>fine sd</u>	<u>250</u>	<u>284</u>
<u>clay - silt</u>	<u>284</u>	<u>376</u>
<u>fine sd</u>	<u>376</u>	<u>405</u>
<u>Red gravel - sd</u>	<u>405</u>	<u>412</u>
<u>clay - silt</u>	<u>412</u>	<u>505</u>
<u>coarse sd</u>	<u>505</u>	<u>546</u>


DEPT. OF NATURAL RESOURCES
BUREAU OF LAND & WATER RESOURCES

FEB 19 1981
RECEIVED

DRILLERS REMARKS: N/A

If well telescopes please sketch and show depths.

GROUND LEVEL

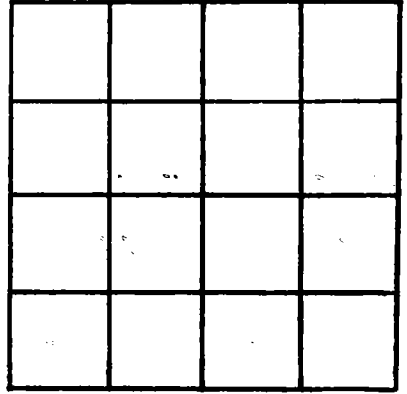

SECTION 27

Please indicate well location X.

ADDITIONAL INFORMATION

If more than one screen, show locations of each on sketch.