

MISSISSIPPI DEPARTMENT OF NATURAL RESOURCES

Bureau of Land and Water Resources

Southport Mall

P.O. Box 10631

Jackson, Mississippi 39209

WATER WELL DRILLERS LOG

Hancock  
K 234/3  
2/20/81

Feb 20 1981  
date well completed

Cochran Brothers Drilling Co. Hancock  
firm name

Hancock  
county well located

LANDOWNER:	description of formations encountered	from	to
<u>M. G. Morgan</u>			
<u>Pt. 4 Hattiesburg</u> (mailing address)	<u>Top soil</u>	<u>0</u>	<u>1</u>
	<u>gray clay</u>	<u>1</u>	<u>7</u>
	<u>sand</u>	<u>7</u>	<u>21</u>
<b>WELL LOCATION:</b>	<u>gray clay</u>	<u>21</u>	<u>35</u>
sec. <u>40</u> T. <u>8</u> N. R. <u>14</u> E.	<u>sand</u>	<u>35</u>	<u>46</u>
<u>1 1/2</u> miles <u>N</u> of <u>Waveland</u>	<u>blue clay</u>	<u>46</u>	<u>105</u>
(distance) (direction) (nearest town)	<u>sand</u>	<u>105</u>	<u>135</u>
<b>WELL PURPOSE:</b> <u>Fish camp</u> (home, irrigation, municipal, industrial)			
<b>WELL COMPLETION DATA:</b>			
(1) diameter (inches) <u>2"</u>			
(2) total depth (feet) <u>135'</u>			
(3) static water level (feet) <u>5</u> <u>below</u> top of ground.			
(4) casing <u>PVC</u> , <u>125'</u> (material) (depth)			
_____ If telescope see back. (size)			
(5) screen <u>10"</u> , <u>125'</u> (length) (depth to top)			
<u>2"</u> , <u>PVC</u> (size) (material)			
(6) pump <u>1</u> , <u>12</u> (HP) (yield gpm)			
<u>Elec.</u> (type power)			
(7) electric log <u>no</u> (yes or no)			
_____ (organization running log)			
(8) how well bottom plugged <u>valve</u>			
<b>DRILLERS REMARKS:</b>			


DEPT. OF NATURAL RESOURCES  
BUREAU OF LAND & WATER RESOURCES

MAR - 6 1981

RECEIVED

If well telescopes please sketch and show depths.

GROUND LEVEL

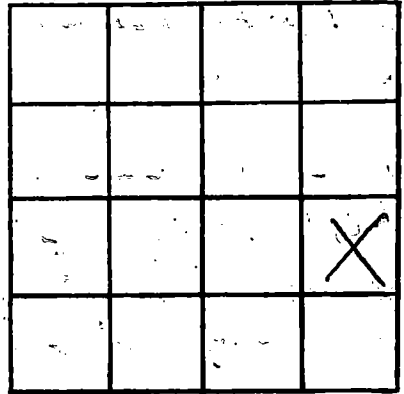

SECTION 40

Please indicate well location X.

ADDITIONAL INFORMATION

If more than one screen, show locations of each on sketch.