


MISSISSIPPI DEPARTMENT OF NATURAL RESOURCES
 Bureau of Land and Water Resources
 Southport Mall
 P.O. Box 10684
 Jackson, Mississippi 39209
WATER WELL DRILLERS LOG

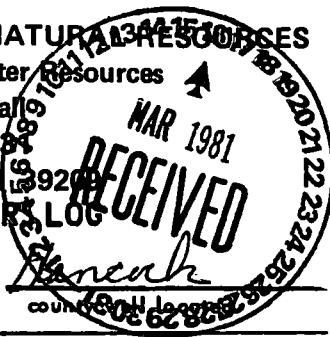

Hancock
K 23 45
2/23/81
2-23-
 date well completed

St. Ward Well Drg.
 firm name

Hancock
 county

LANDOWNER: Beany's Air
 Hwy 90
 Bay St. Louis mo.
 (mailing address)

description of formations encountered	from	to
<u>top soil - clay</u>	<u>0</u>	<u>15</u>
<u>sand</u>	<u>15</u>	<u>38</u>
<u>clay</u>	<u>38</u>	<u>112</u>
<u>clay</u>	<u>112</u>	<u>130</u>
<u>clay</u>	<u>130</u>	<u>154</u>
<u>Red gravel - sd</u>	<u>154</u>	<u>168</u>

WELL LOCATION:
 sec. 33 T. 8 N R. 13 E 14 W
2 miles (distance) W (direction) Warland (nearest town)

WELL PURPOSE: Business
 (home, irrigation, municipal, industrial)

- WELL COMPLETION DATA:
- (1) diameter (inches) 2"
 - (2) total depth (feet) 168
 - (3) static water level (feet) 10 ^{below} top of ground.
 - (4) casing PVC, 158,
 (material) (depth)
 - (5) screen 10' -
 (length) (depth to top)
2" PVC
 (size) (material)
 - (6) pump win
 (HP) (yield gpm)
 (type power)
 - (7) electric log NO
 (yes or no)
N/A
 (organization running log)
 - (8) how well bottom plugged BWV

DRILLERS REMARKS: N/A

DEPT. OF NATURAL RESOURCES
 BUREAU OF LAND & WATER RESOURCES

MAR 16 1981

RECEIVED

If well telescopes please sketch and show depths.

GROUND LEVEL

SECTION _____

Please indicate well location X.

ADDITIONAL INFORMATION

If more than one screen,
show locations of each on sketch.