

MISSISSIPPI DEPARTMENT OF NATURAL RESOURCES

Bureau of Land and Water Resources

Southport Mall

P.O. Box 10631

Jackson, Mississippi 39209

WATER WELL DRILLERS LOG

HANCOCK
K 23 46
3-11-81

3-11- 1981 WARD WELL DLG. Hancock
date well completed firm name county well located

LANDOWNER: WELDON J. TULLIER
IOWA STREET
Bay St. Louis, ms.
(mailing address)

| description of formations encountered | depth | |
|---------------------------------------|-----------|------------|
| | from | to |
| <u>Clay</u> | <u>0</u> | <u>18</u> |
| <u>Sand</u> | <u>15</u> | <u>45</u> |
| <u>Clay</u> | <u>45</u> | <u>96</u> |
| <u>Med coarse sand</u> | <u>96</u> | <u>120</u> |

WELL LOCATION:
sec 28 T 8 N R 14 E
10 miles N of Waveland
(distance) (direction) (nearest town)

WELL PURPOSE: camp
(home, irrigation, municipal, industrial)

WELL COMPLETION DATA:

(1) diameter (inches) 2"

(2) total depth (feet) 120

(3) static water level (feet) 3 below above top of ground.

(4) casing PVC 110
(material) (depth)

— (size) if telescope see back.

(5) screen 10' —
(length) (depth to top)

2" PVC
(size) (material)

(6) pump owner
(HP) (yield gpm)

—
(type power)

(7) electric log no
(yes or no)

NIA
(organization running log)

(8) how well bottom plugged BWV

DEPT. OF NATURAL RESOURCES
BUREAU OF LAND & WATER RESOURCES


APR 16 1981

RECEIVED

DRILLERS REMARKS: well located in Shoreline Park.

If well telescopes please sketch and show depths.

GROUND LEVEL

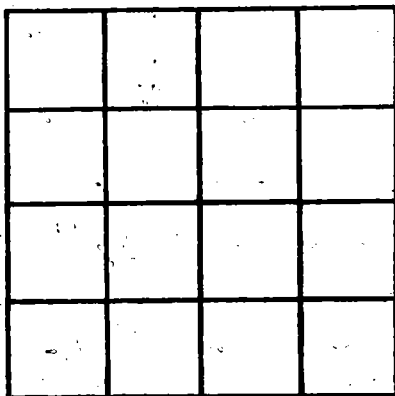

SECTION 28

Please indicate well location X.

ADDITIONAL INFORMATION

If more than one screen, show locations of each on sketch.