

MISSISSIPPI DEPARTMENT OF NATURAL RESOURCES

Bureau of Land and Water Resources

Southport Mall

P.O. Box 10631

Jackson, Mississippi 39209

WATER WELL DRILLERS LOG

HANCOCK
K 2347
3-17-81

3-17- 19**81** **Ward Well Drg.** **Hancock**
 date well completed firm name county well located

LANDOWNER **Keon B. Super Jr.**
West Osageana
Bay St. Louis, Ms.
 (mailing address)

description of formations encountered	from	to
Top Soil - clay	0	18
sd	18	45
clay - shell	45	96
sd	96	132
clay	132	155
Red Shell - sd	155	200

WELL LOCATION:
 sec. **6** T. **9** N. R. **14** E
 (S) (W)
75 miles **W** of **Waveland**
 (distance) (direction) (nearest town)

WELL PURPOSE: **1 point**
 (home, irrigation, municipal, industrial)

WELL COMPLETION DATA:

(1) diameter (inches) **2"**

(2) total depth (feet) **200**

(3) static water level (feet) **10** **below** top of ground. **above**

(4) casing **PVC** **190**
 (material) (depth)

— if telescope see back.
 (size)

(5) screen **10'** **—**
 (length) (depth to top)

2" **PVC**
 (size) (material)

(6) pump **owner** **—**
 (HP) (yield gpm)

—
 (type power)

(7) electric log **NO**
 (yes or no)

N/A
 (organization running log)

(8) how well bottom plugged **BWV**


DRILLERS REMARKS: **Well Sec. Bay Side Indus**

DEPT. OF NATURAL RESOURCES
 BUREAU OF LAND & WATER RESOURCES

APR 16 1981
RECEIVED

If well telescopes please sketch and show depths.

GROUND LEVEL

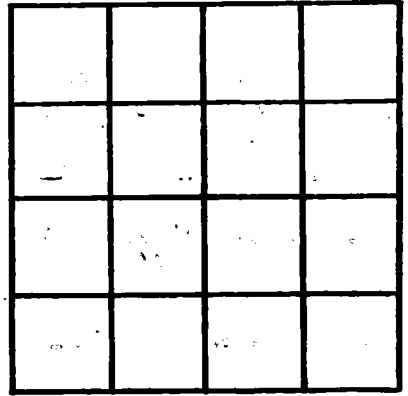

SECTION 6

Please indicate well location X.

ADDITIONAL INFORMATION

If more than one screen, show locations of each on sketch.