

MISSISSIPPI DEPARTMENT OF NATURAL RESOURCES

Bureau of Land and Water Resources

Southport Mall

P.O. Box 10631

Jackson, Mississippi 39209

WATER WELL DRILLERS LOG

Hancock
K 2348
3-16-81

3-16 1981 Ward Well Dr. Hancock
 date well completed firm name county well located


LANDOWNER:	description of formations encountered	from	to
<u>Glenn Bonano</u>	<u>Fill-Clay</u>	<u>0</u>	<u>15'</u>
<u>Rt. 2, Box # 814 N</u>	<u>SD</u>	<u>15</u>	<u>36</u>
<u>Boy St. Louis, Mo.</u>	<u>Clay</u>	<u>36</u>	<u>105</u>
(mailing address)	<u>Black Shale-SD</u>	<u>105</u>	<u>110</u>
WELL LOCATION:	<u>Clay-Silt</u>	<u>110</u>	<u>212</u>
sec. <u>10</u> T. <u>8</u> N R. <u>12</u> E	<u>Coarse SD</u>	<u>212</u>	<u>230</u>
<u>12</u> miles <u>N/W</u> of <u>Waveland</u>			
(distance) (direction) (nearest town)			
WELL PURPOSE: <u>Home</u>			
(home, irrigation, municipal, industrial)			
WELL COMPLETION DATA:			
(1) diameter (Inches) <u>2"</u>			
(2) total depth (feet) <u>230</u>			
(3) static water level (feet) <u>3</u> <u>below</u> above top of ground.			
(4) casing <u>PVC</u> <u>220</u>			
(material) (depth)			
(size) if telescope see back.			
(5) screen <u>10'</u> <u>-</u>			
(length) (depth to top)			
<u>2"</u> <u>PVC</u>			
(size) (material)			
(6) pump <u>none</u> <u>-</u>			
(HP) (yield gpm)			
(type power)			
(7) electric log <u>NO</u>			
(yes or no)			
<u>MA</u>			
(organization running log)			
(8) how well bottom plugged <u>BWU</u>			
DRILLERS REMARKS: <u>well log</u>			
<u>Boyton Drilling Suster</u>			

DEPT. OF NATURAL RESOURCES
 BUREAU OF LAND & WATER RESOURCES

APR 16 1981
 RECEIVED

If well telescopes please sketch and show depths.

GROUND LEVEL

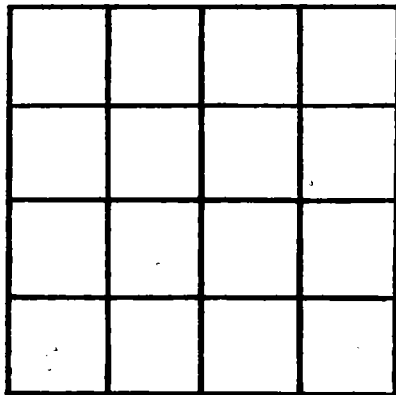

SECTION 10

Please indicate well location X.

ADDITIONAL INFORMATION

If more than one screen, show locations of each on sketch.