

MISSISSIPPI DEPARTMENT OF NATURAL RESOURCES

Bureau of Land and Water Resources

Southport Mall

P.O. Box 10631

Jackson, Mississippi 39209

WATER WELL DRILLERS LOG

HANCOCK
K 2349
4-13-81

4-13 1981 81 Ward Well Dr. Hancock
 date well completed firm name county well located

LANDOWNER: <u>Ruth Ranson</u>	description of formations encountered	from	to
<u>Leak St.</u>	<u>Top Soil - clay</u>	<u>0</u>	<u>18</u>
<u>Bay St. Louis, ms.</u>	<u>sd</u>	<u>18</u>	<u>36</u>
(mailing address)	<u>clay</u>	<u>36</u>	<u>97</u>
	<u>Coard sd</u>	<u>97</u>	<u>128</u>
	<u>clay</u>	<u>128</u>	<u>149</u>
	<u>Red gravel - sd</u>	<u>149</u>	<u>165</u>

WELL LOCATION:
 sec. 6 T 9 N R 14 E
12 miles W of Waveland
 (distance) (direction) (nearest town)

WELL PURPOSE: Home
 (home, irrigation, municipal, industrial)

WELL COMPLETION DATA:

(1) diameter (inches) 2"

(2) total depth (feet) 165

(3) static water level (feet) 9 ^{below} _{above} top of ground.

(4) casing PVC 155
 (material) (depth)

(size) if telescope see back.

(5) screen 10' -
 (length) (depth to top)

2" PVC
 (size) (material)

(6) pump Orms -
 (HP) (yield gpm)

(type power)

(7) electric log no
 (yes or no)

NIA
 (organization running log)

(8) how well bottom plugged BWU

DRILLERS REMARKS:


DEPT. OF NATURAL RESOURCES
 BUREAU OF LAND & WATER RESOURCES

MAY 14 1981

RECEIVED

If well telescopes please sketch and show depths.

GROUND LEVEL

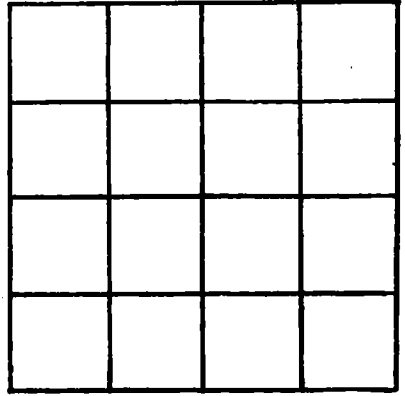

SECTION 6

Please indicate well location X.

ADDITIONAL INFORMATION

If more than one screen,
show locations of each on sketch.