

MISSISSIPPI DEPARTMENT OF NATURAL RESOURCES

Bureau of Land and Water Resources

Southport Mall

P.O. Box 10631

Jackson, Mississippi 39209

WATER WELL DRILLERS LOG

HANCOCK
K 2351
4-7-81

4-7- 1981 Ward Well Drilling Hancock
 date well completed firm name county well located

LANDOWNER:	description of formations encountered	from	to
<u>Erroy Williams</u> <u>Led Lyman Sudv.</u>	<u>Top Gal - clay</u>	<u>0</u>	<u>18</u>
<u>Boy St. Louis, ms.</u> (mailing address)	<u>clay - shell</u>	<u>18</u>	<u>46</u>
	<u>sd</u>	<u>46</u>	<u>95</u>
	<u>clay</u>	<u>95</u>	<u>115</u>
	<u>clay</u>	<u>115</u>	<u>160</u>
	<u>Red Shell - sd</u>	<u>160</u>	<u>176</u>
	<u>clay - silt</u>	<u>176</u>	<u>280</u>
	<u>fine sd</u>	<u>280</u>	<u>305</u>
	<u>clay - silt</u>	<u>305</u>	<u>376</u>
	<u>coarse sd</u>	<u>376</u>	<u>420</u>

WELL LOCATION:
 sec. 22 T-8 N R-18 E
3 miles (distance) N/W of B. Side (direction) (nearest town)

WELL PURPOSE: Home
 (home, irrigation, municipal, industrial)

WELL COMPLETION DATA:

(1) diameter (inches) 2"

(2) total depth (feet) 420

(3) static water level (feet) 1 below above top of ground.

(4) casing PVC 410
 (material) (depth)

_____ if telescope see back.
 (size)

(5) screen 10' _____
 (length) (depth to top)

2" PVC
 (size) (material)

(6) pump owner
 (HP) (yield gpm)

Elec.
 (type power)

(7) electric log no
 (yes or no)

N/A
 (organization running log)

(8) how well bottom plugged BWU

DRILLERS REMARKS: N/A


DEPT. OF NATURAL RESOURCES
 BUREAU OF LAND & WATER RESOURCES

MAY 14 1981

RECEIVED

If well telescopes please sketch and show depths.

GROUND LEVEL

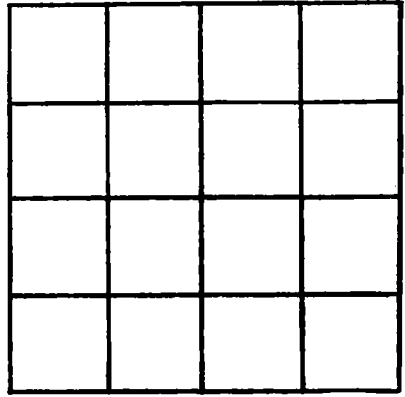

SECTION 22

Please indicate well location X.

ADDITIONAL INFORMATION

A series of horizontal lines for recording additional information.

If more than one screen, show locations of each on sketch.