

Hancock
K 2352
4-22-81

MISSISSIPPI
BOARD OF WATER COMMISSIONERS
416 North State Street
Jackson, Mississippi 39201

WATER WELL DRILLERS LOG

4-22-1981 date well completed
Ward Well Dlg. firm name
Hancock county well located

LANDOWNER	description of formations encountered	from	to
Rt. 1, Box 114	Top Soil - clay	0	18
Box St. Louis, ms.	Clay	18	42
(mailing address)	sd	42	76
	sd	76	85
	Clay	85	105
	Coarse sd	105	124

LANDOWNER: Rolen Wilkerson

WELL LOCATION:

sec. 29 T 8 N R 13 E
7 miles N/W of Wardland
(distance) (direction) (nearest town)

WELL PURPOSE: None
(home, irrigation, municipal, industrial)

WELL COMPLETION DATA:

- (1) diameter (inches) 2"
- (2) total depth (feet) 124
- (3) static water level (feet) 4 ^{below} top of ground
- (4) casing PVC 114
(material) (depth)
- (size) if telescope see back.
- (5) screen 10' -
(length) (depth to top)
- 2" PVC
(size) (material)
- (6) pump owner -
(HP) (yield gpm)
- (type power)
- (7) electric log NO
(yes or no)
- N/A
(organization running log)
- (8) how well bottom plugged BWU

DRILLERS REMARKS: N/A


DEPT. OF NATURAL RESOURCES
BUREAU OF LAND & WATER RESOURCES

JUN 2 - 1981

RECEIVED

If well telescopes please sketch and show depths.

GROUND LEVEL

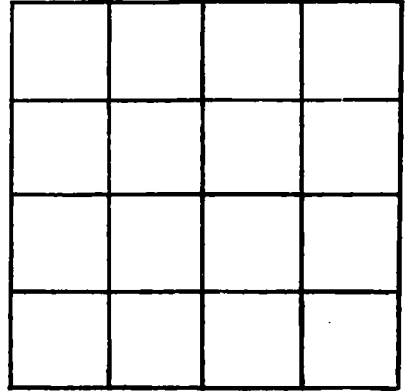

SECTION 29

Please indicate well location X.

ADDITIONAL INFORMATION

If more than one screen, show locations of each on sketch.