

HANCOCK
K 2357

MISSISSIPPI
BOARD OF WATER COMMISSIONERS
416 North State Street
Jackson, Mississippi 39201

WATER WELL DRILLERS LOG

5/26/81
5-26

1981 Ward Well Pkg


Hancock

date well completed

firm name

county well located

LANDOWNER: Joe Calamar	description of formations encountered	from	to
Boy Road	Top Soil - clay	0	18
Bay St. Louis ms. (mailing address)	sd	18	36
	clay - shell	36	95
	Red shale - sd	95	116
	Clay - silt	116	204
	Cobble sd	204	225
WELL LOCATION:			
sec. 9 T 9 N R 14 E			
(distance) miles (direction) of (nearest town)			
WELL PURPOSE: Home (home, irrigation, municipal, industrial)			
WELL COMPLETION DATA:			
(1) diameter (inches) 2"			
(2) total depth (feet) 225			
(3) static water level (feet) 10 below top of ground			
(4) casing PUC 215 (material) (depth)			
(size) if telescope see back.			
(5) screen 10' (length) (depth to top)			
2" PVC (size) (material)			
(6) pump Corwin (HP) (yield gpm)			
(type power)			
(7) electric log NO (yes or no)			
(organization running log) N/A			
(8) how well bottom plugged BWU			
DRILLERS REMARKS: N/A			

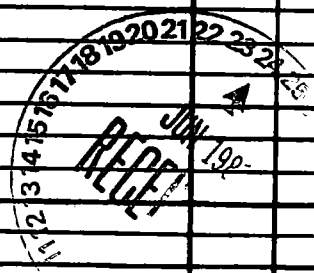

If well telescopes please sketch and show depths.

GROUND LEVEL

SECTION 9

Please indicate well location X.

ADDITIONAL INFORMATION

If more than one screen, show locations of each on sketch.

