

HANCOCK
K 23 38
5-26-81

MISSISSIPPI
 BOARD OF WATER COMMISSIONERS
 416 North State Street
 Jackson, Mississippi 39201

WATER WELL DRILLERS LOG

5-26 1981 Wardwell Dlg. Hancock
 date well completed firm name county well located

LANDOWNER: Raymond Reed
Whale & Bass St.
Bay St. Loring, ms.
 (mailing address)

description of formations encountered	from	to
<u>fill - clay</u>	<u>0</u>	<u>26</u>
<u>sd</u>	<u>26</u>	<u>42</u>
<u>clay</u>	<u>42</u>	<u>104</u>
<u>fine sd</u>	<u>104</u>	<u>116</u>
<u>clay - silt</u>	<u>116</u>	<u>160</u>
<u>silty sd</u>	<u>160</u>	<u>173</u>
<u>med. coarse sd</u>	<u>173</u>	<u>196</u>

WELL LOCATION:
 sec. 28 T 8 N R 14 E
10 miles N of Waveland
 (distance) (direction) (nearest town)

WELL PURPOSE: camp
 (home, irrigation, municipal, industrial)


- WELL COMPLETION DATA:
- (1) diameter (inches) 2"
 - (2) total depth (feet) 190
 - (3) static water level (feet) 5 ^{below} _{above} top of ground.
 - (4) casing PVC 180
 (material) (depth)
 (size) if telescope see back.
 - (5) screen 10' -
 (length) (depth to top)
2" PVC
 (size) (material)
 - (6) pump runner -
 (HP) (yield gpm)
 (type power)
 - (7) electric log NO
 (yes or no)
N/A
 (organization running log)
 - (8) how well bottom plugged BUN

DRILLERS REMARKS: N/A



If well telescopes please sketch and show depths.

GROUND LEVEL

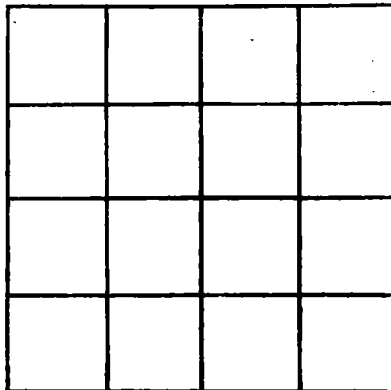

SECTION 28

Please indicate well location X.

ADDITIONAL INFORMATION

If more than one screen,
show locations of each on sketch.