

MISSISSIPPI DEPARTMENT OF NATURAL RESOURCES

Bureau of Land and Water Resources

Southport Mall

P.O. Box 10631

Jackson, Mississippi 39209

WATER WELL DRILLERS LOG

HANCOCK
R 2362
6-24-81

Date well completed June 24 1981 firm name Duncan Well Drilling county well located Hancock

LANDOWNER: Otis Webb
Rt. 11 Box 304
Shepard
(mailing address)

description of formations encountered	depth	
	from	to
<u>Sand</u>	<u>0</u>	<u>60</u>
<u>Blue Clay</u>	<u>60</u>	<u>110</u>
<u>fine sand</u>	<u>110</u>	<u>140</u>
<u>Coarse Sand</u>	<u>140</u>	<u>160</u>

WELL LOCATION:
sec. 39 T 2 N R 14 E
4 miles N.W. of Bay St. Louis
(distance) (direction) (nearest town)

WELL PURPOSE: camp
(home, irrigation, municipal, industrial)

WELL COMPLETION DATA:

- (1) diameter (inches) 2"
- (2) total depth (feet) 160 ft.
- (3) static water level (feet) 1' below top of ground. above
- (4) casing PVC 150'
(material) (depth)
10' If telescope see back.
(size)
- (5) screen 10' 150'
(length) (depth to top)
2" PVC
(size) (material)
- (6) pump 1/2 14
(HP) (yield gpm)
electric
(type power)
- (7) electric log
(yes or no)


(organization running log)
- (8) how well bottom plugged Sand
shank

DRILLERS REMARKS: Owner
had his own
pump

DEPT. OF NATURAL RESOURCES
BUREAU OF LAND & WATER RESOURCES
RECEIVED
OCT 19 1981

If well telescopes please sketch and show depths.

GROUND LEVEL

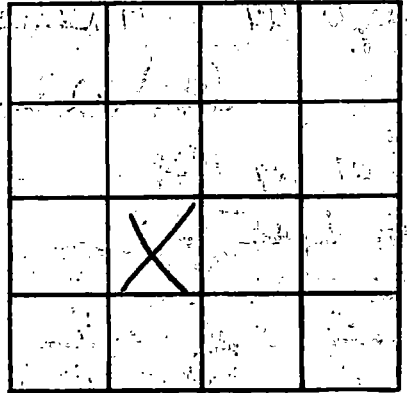

SECTION 39

Please indicate well location X.

ADDITIONAL INFORMATION

If more than one screen, show locations of each on sketch.