

Hancock  
K 2364  
7-7-81

MISSISSIPPI  
 BOARD OF WATER COMMISSIONERS  
 416 North State Street  
 Jackson, Mississippi 39201

WATER WELL DRILLERS LOG

7-7-1981 Wood Well Dlg. Hancock  
 date well completed firm name county well located

LANDOWNER: Arnold Jones  
Cardinal St.  
Boy St. Louis, ms.  
 (mailing address)


description of formations encountered	from	to
Clay	0	15
Sd	15	42
Clay	42	80
Sd	80	95
Clay	95	116
Consd Sd	116	140

WELL LOCATION:  
 sec. 39 T-8 N R-13 E 14  
10 miles W of Waveland  
 (distance) (direction) (nearest town)

WELL PURPOSE: Home  
 (home, irrigation, municipal, industrial)

- WELL COMPLETION DATA:
- (1) diameter (inches) 2"
  - (2) total depth (feet) 140
  - (3) static water level (feet) 4 below top of ground
  - (4) casing PVC 130  
 (material) (depth)
  - (size) If telescope see back.
  - (5) screen 10' -  
 (length) (depth to top)
  - 2" PVC  
 (size) (material)
  - (6) pump Unus  
 (HP) (yield gpm)
  - (type power)
  - (7) electric log NO  
 (yes or no)
  - N/A  
 (organization running log)
  - (8) how well bottom plugged BWW

DRILLERS REMARKS: N/A

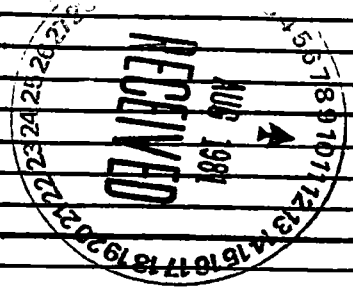

If well telescopes please sketch and show depths.

GROUND LEVEL


SECTION

39

Please indicate well location X.

ADDITIONAL INFORMATION

If more than one screen, show locations of each on sketch.

