


Hancock
K 2365
7-9-81
7-9-

MISSISSIPPI
 BOARD OF WATER COMMISSIONERS
 416 North State Street
 Jackson, Mississippi 39201

WATER WELL DRILLERS LOG

date well completed 1981 firm name Ward Well Dr. county well located Hancock

LANDOWNER: <u>Fred Katool</u>	description of formations encountered	from	to
<u>Deal St.</u>	<u>Clay</u>	<u>0</u>	<u>21</u>
<u>Boy St. Service, Inc.</u> (mailing address)	<u>SD</u>	<u>21</u>	<u>35</u>
	<u>Clay</u>	<u>35</u>	<u>76</u>
	<u>SD</u>	<u>76</u>	<u>88</u>
WELL LOCATION: sec. <u>31</u> T. <u>8</u> N. R. <u>18</u> E. <u>14</u>	<u>Clay</u>	<u>88</u>	<u>137</u>
<u>10</u> miles <u>N/W</u> of <u>Wardland</u>	<u>Coke SD</u>	<u>137</u>	<u>152</u>
WELL PURPOSE: <u>Camp</u> (home, irrigation, municipal, industrial)			
WELL COMPLETION DATA:			
(1) diameter (inches) <u>2"</u>			
(2) total depth (feet) <u>152</u>			
(3) static water level (feet) <u>2</u> <u>below</u> top of ground.			
(4) casing <u>PVC</u> <u>142</u> (material) (depth)			
- (size) If telescope see back.			
(5) screen <u>10'</u> <u>-</u> (length) (depth to top)			
<u>2"</u> <u>PVC</u> (size) (material)			
(6) pump <u>owner</u> (HP) (yield gpm)			
- (type power)			
(7) electric log <u>NO</u> (yes or no)			
<u>N/A</u> (organization running log)			
(8) how well bottom plugged <u>BWU</u>			
DRILLERS REMARKS: <u>N/A</u>			

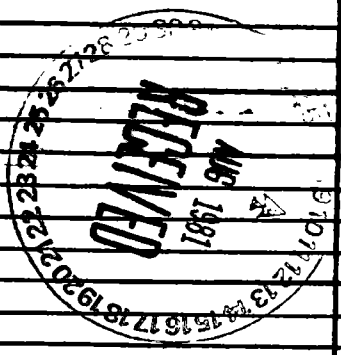

If well telescopes please sketch and show depths.

GROUND LEVEL

SECTION 31

Please indicate well location X.

ADDITIONAL INFORMATION

If more than one screen, show locations of each on sketch.