

HANCOCK
K 2367
7-20-81

**MISSISSIPPI
 BOARD OF WATER COMMISSIONERS
 416 North State Street
 Jackson, Mississippi 39201**

WATER WELL DRILLERS LOG

7-20 19**81** Ward Well Drg. Hancock
 date well completed firm name county well located

LANDOWNER: Clarence Schindler
Chapman Rd.
Bay St. Louis, Ms.
 (mailing address)

description of formations encountered	from	to
<u>Clay - fill</u>	<u>0</u>	<u>15</u>
<u>sd</u>	<u>15</u>	<u>45</u>
<u>Clay</u>	<u>45</u>	<u>96</u>
<u>fine sd</u>	<u>96</u>	<u>112</u>
<u>Clay - silt</u>	<u>112</u>	<u>127</u>
<u>sd</u>	<u>127</u>	<u>145</u>

WELL LOCATION:
 sec. 22 T. 9 N. R. 13 E.
7 miles N/W of B.S.L.
 (distance) (direction) (nearest town)

WELL PURPOSE: Camp
 (home, irrigation, municipal, industrial)

- WELL COMPLETION DATA:**
- (1) diameter (inches) 2"
 - (2) total depth (feet) 145
 - (3) static water level (feet) 2 below above top of ground.
 - (4) casing PVC 135'
 (material) (depth)
 (size) If telescope see back.
 - (5) screen 10' -
 (length) (depth to top)
2" PVC
 (size) (material)
 - (6) pump crank -
 (HP) (yield gpm)
 (type power)
 - (7) electric log NO
 (yes or no)
N/A
 (organization running log)
 - (8) how well bottom plugged BWV

DRILLERS REMARKS: N/A




If well telescopes please
sketch and show depths.

GROUND LEVEL

SECTION 22

Please indicate well location X.

ADDITIONAL INFORMATION

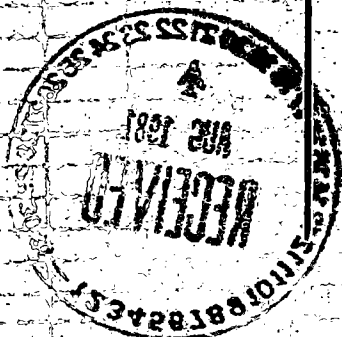

If more than one screen,
show locations of each on sketch.