

HANCOCK

K 23 68

8-10-81

MISSISSIPPI BOARD OF WATER COMMISSIONERS
416 North State Street
Jackson, Mississippi 39201

WATER WELL DRILLERS LOG

8-10-

date well completed

19 81 Woodwell Dr.

firm name

Hancock

county well located

LANDOWNER:

Shelton Beumond

Kemper St.

Bay St. Louis, ms.
(mailing address)

description of formations encountered

Top Soil-clay

from

to

0 18

18 46

46 105

105 127

127 152

152 169

WELL LOCATION:

sec. 6 T 9 N R 14 E
8 miles W of Waveland
(distance) (direction) (nearest town)

WELL PURPOSE:

Home
(home, irrigation, municipal, industrial)

WELL COMPLETION DATA:

- (1) diameter (inches) 2"
- (2) total depth (feet) 167
- (3) static water level (feet) 10 ^{below} above top of ground
- (4) casing PVC, 157 (material), (depth)
- (size) if telescope see back.
- (5) screen 10' (length), (depth to top)
2" (size), PVC (material)
- (6) pump owner (HP), (yield gpm)
(type power)
- (7) electric log NO (yes or no)
N/A (organization running log)
- (8) how well bottom plugged BWV

DRILLERS REMARKS:


N/A

DEPT. OF NATURAL RESOURCES
BUREAU OF LAND & WATER RESOURCES

SEP 10 1981

RECEIVED

If well telescopes please sketch and show depths.

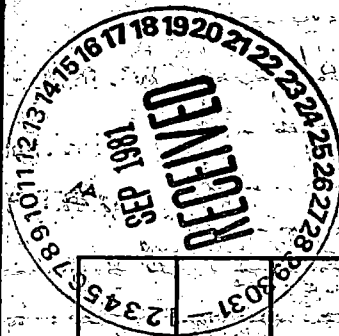

GROUND LEVEL

SECTION 6

Please indicate well location X.

ADDITIONAL INFORMATION

If more than one screen, show locations of each on sketch.