

HANCOCK  
K-2369  
8-11-81

MISSISSIPPI  
BOARD OF WATER COMMISSIONERS  
416 North State Street  
Jackson, Mississippi 39201

WATER WELL DRILLERS LOG

1981 Ward Well Drg. Hancock  
date well completed firm name county well located

LANDOWNER: <u>Donald Russell</u>	description of formations encountered	from	to
<u>Sake Shae Rd.</u>			
<u>Bay St. Louis, ms.</u>	<u>sd</u>	<u>21</u>	<u>45</u>
(mailing address)	<u>clay</u>	<u>45</u>	<u>96</u>
WELL LOCATION:	<u>sd</u>	<u>96</u>	<u>118</u>
sec. <u>7</u> T. <u>9</u> N. R. <u>14</u> E	<u>clay</u>	<u>118</u>	<u>271</u>
<u>14</u> miles <u>S/W</u> of <u>B.S.L.</u>	<u>cone sd</u>	<u>271</u>	<u>294</u>
(distance) (direction) (nearest town)			
WELL PURPOSE: <u>Home</u>			
(home, irrigation, municipal, industrial)			
WELL COMPLETION DATA:			
(1) diameter (inches) <u>2"</u>			
(2) total depth (feet) <u>294</u>			
(3) static water level (feet) <u>10</u> <u>below</u> above top of ground.			
(4) casing <u>PVC</u> <u>284</u>			
(material) (depth)			
(size) If telescope see back.			
(5) screen <u>10'</u> <u>-</u>			
(length) (depth to top)			
<u>2"</u> <u>PVC</u>			
(size) (material)			
(6) pump <u>1/2</u> <u>10</u>			
(HP) (yield gpm)			
<u>elec.</u>			
(type power)			
(7) electric log <u>NO</u>			
(yes or no)			
<u>N/A</u>			
(organization running log)			
(8) how well bottom plugged <u>BWU</u>			
DRILLERS REMARKS: <u>N/A</u>			


DEPT. OF NATURAL RESOURCES  
BUREAU OF LAND & WATER RESOURCES

SEP 10 1981

RECEIVED

If well telescopes please sketch and show depths.

GROUND LEVEL

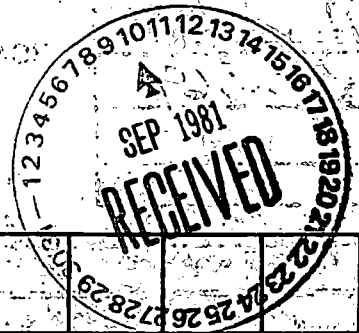


SECTION 7

Please indicate well location X.

ADDITIONAL INFORMATION

If more than one screen, show locations of each on sketch.