

MISSISSIPPI DEPARTMENT OF NATURAL RESOURCES

Bureau of Land and Water Resources

Southport Mall

P.O. Box 10631

Jackson, Mississippi 39209

WATER WELL DRILLERS LOG

Hancock
K 2371

8-24-1982 Wood Well Drg. Hancock
date well completed firm name county well located

LANDOWNER Walter Tedesco
Dolphin St.
Bay St. Louis, ms.
(mailing address)

| description of formations encountered | from | to |
|---------------------------------------|------|-----|
| Clay | 0 | 20 |
| sd | 20 | 42 |
| Clay | 42 | 97 |
| fine sd | 97 | 115 |
| Clay | 115 | 162 |
| sd | 162 | 128 |
| Clay - Silt | 128 | 362 |
| sd | 362 | 394 |
| Clay - Silt | 394 | 505 |
| Coarse sd | 505 | 546 |

WELL LOCATION:
sec 27 T 8 N R 13 E 14
10 miles N of B.S.L.
(distance) (direction) (nearest town)

WELL PURPOSE: None
(home, irrigation, municipal, industrial)

WELL COMPLETION DATA:
(1) diameter (inches) 2"
(2) total depth (feet) 546
(3) static water level (feet) 10 below top of ground. above
(4) casing PVC 526,
(material) (depth)
- if telescope see back.
(size)
(5) screen 20 -
(length) (depth to top)
2" PVC
(size) (material)
(6) pump 1/2 12
(HP) (yield gpm)
Elco
(type power)
(7) electric log NO
(yes or no)
N/A
(organization running log)
(8) how well bottom plugged BWU

DRILLERS REMARKS: N/A


DEPT. OF NATURAL RESOURCES
BUREAU OF LAND & WATER RESOURCES

SEP 23 1982

RECEIVED

If well telescopes please sketch and show depths.

GROUND LEVEL

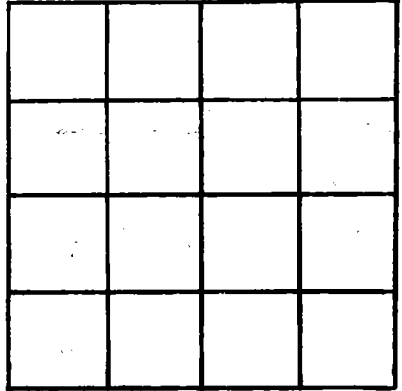

SECTION 10

Please indicate well location X.

ADDITIONAL INFORMATION

If more than one screen, show locations of each on sketch.