

MISSISSIPPI DEPARTMENT OF NATURAL RESOURCES

Bureau of Land and Water Resources

Southport Mall

P.O. Box 10631

Jackson, Mississippi 39209

WATER WELL DRILLERS LOG

Hancock
K-2374

9-16- 1982 Wood Well Drg. Hancock
date well completed firm name county well located

LANDOWNER: <u>Fred Blomgren</u>	description of formations encountered	from	to
<u>19th St.</u>			
<u>Bay St. Louis mo.</u> (mailing address)	<u>fill - clay</u>	<u>0</u>	<u>18</u>
	<u>sd</u>	<u>18</u>	<u>45</u>
	<u>clay</u>	<u>45</u>	<u>95</u>
	<u>sd</u>	<u>95</u>	<u>112</u>
	<u>clay - silt</u>	<u>112</u>	<u>131</u>
	<u>sd</u>	<u>131</u>	<u>170</u>

WELL LOCATION:
sec 28 T 8 N R 13 E 14
0.6 miles N of Wardlaw
(distance) (direction) (nearest town)

WELL PURPOSE: camp
(home, irrigation, municipal, industrial)

- WELL COMPLETION DATA:
- (1) diameter (inches) 2"
 - (2) total depth (feet) 150'
 - (3) static water level (feet) 4 below above top of ground.
 - (4) casing PVC, 140'
(material) (depth)
- (size) If telescope see back.
 - (5) screen 10', -
(length) (depth to top)
2", PVC
(size) (material)
 - (6) pump owner
(HP) (yield gpm)
- (type power)
 - (7) electric log NO
(yes or no)
N/A
(organization running log)
 - (8) how well bottom plugged BWD

DRILLERS REMARKS: N/A


DEPT. OF NATURAL RESOURCES
BUREAU OF LAND & WATER RESOURCES

OCT 27 1982

RECEIVED

If well telescopes please sketch and show depths.

GROUND LEVEL

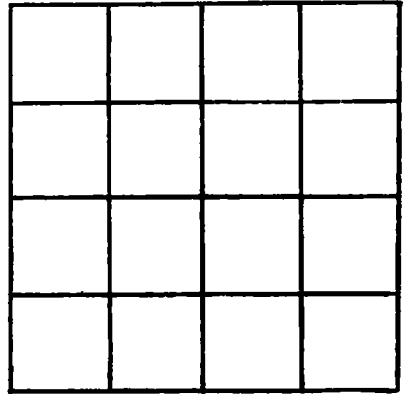

SECTION 28

Please indicate well location X.

ADDITIONAL INFORMATION

If more than one screen, show locations of each on sketch.