

MISSISSIPPI DEPARTMENT OF NATURAL RESOURCES

Bureau of Land and Water Resources

Southport Mall

P.O. Box 10631

Jackson, Mississippi 39209

WATER WELL DRILLERS LOG

Hancock
K 2375

10-1 1982 Ward Well Dr. Hancock
date well completed firm name county well located

LANDOWNER: <u>Neal Stone</u>	description of formations encountered	from	to
<u> Hwy 603 -</u>			
<u> Bay St. South ms</u> (mailing address)	<u>sd</u>	<u>14</u>	<u>45</u>
	<u>clay - silt</u>	<u>45</u>	<u>110</u>
	<u>fine sd</u>	<u>110</u>	<u>122</u>
	<u>clay - silt</u>	<u>122</u>	<u>181</u>
	<u>fine sd</u>	<u>181</u>	<u>202</u>
WELL LOCATION:			
sec. <u>9</u> T. <u>9</u> N. R. <u>14</u> E.			
<u>10</u> miles <u>N/W</u> of <u>Waveland</u>			
(distance) (direction) (nearest town)			
WELL PURPOSE: <u>Camp</u>			
(home, irrigation, municipal, industrial)			
WELL COMPLETION DATA:			
(1) diameter (Inches)	<u>2"</u>		
(2) total depth (feet)	<u>202</u>		
(3) static water level (feet)	<u>1</u> below top of ground.		
(4) casing (material)	<u>PVC</u>		
	(depth)	<u>192</u>	
	(size)		If telescope see back.
(5) screen (length)	<u>10'</u>		
	(depth to top)	<u>-</u>	
	(size)	<u>2"</u>	
	(material)	<u>PVC</u>	
(6) pump (HP)	<u>1/2</u>		
	(yield gpm)	<u>10</u>	
	(type power)	<u>Elec.</u>	
(7) electric log (yes or no)	<u>NO</u>		
	(organization running log)	<u>N/A</u>	
(8) how well bottom plugged	<u>BWU</u>		
DRILLERS REMARKS: <u>N/A</u>			


DEPT. OF NATURAL RESOURCES
BUREAU OF LAND & WATER RESOURCES

NOV 22 1982

RECEIVED

If well telescopes please sketch and show depths.

GROUND LEVEL

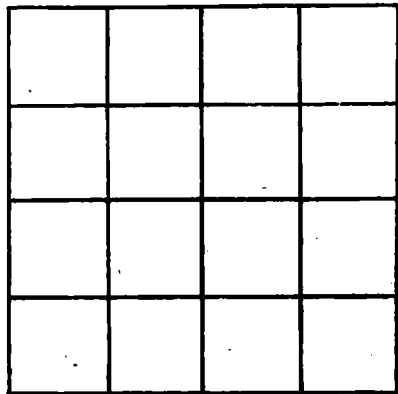

SECTION 40

Please indicate well location X.

ADDITIONAL INFORMATION

If more than one screen, show locations of each on sketch.