

MISSISSIPPI DEPARTMENT OF NATURAL RESOURCES

Bureau of Land and Water Resources

Southport Mall

P.O. Box 10631

Jackson, Mississippi 39209

WATER WELL DRILLERS LOG

Hancock
K2376

10-4 1982 Ward Well Dly Hancock
date well completed firm name county well located

LANDOWNER Jemell Sabner
Sawa Bay Rd
Bay St. Louis, ms.
(mailing address)

description of formations encountered	from	to
<u>Top Soil - Clay</u>	<u>0</u>	<u>18</u>
<u>3d Clay</u>	<u>18</u>	<u>42</u>
<u>Clay</u>	<u>42</u>	<u>95</u>
<u>Red Muck - sd</u>	<u>95</u>	<u>116</u>
<u>Clay - Silt</u>	<u>116</u>	<u>215</u>
<u>at fine sd</u>	<u>215</u>	<u>226</u>
<u>Clay - Silt</u>	<u>226</u>	<u>278</u>
<u>Coke sd</u>	<u>278</u>	<u>310</u>

WELL LOCATION:
sec. 8 T. 9 N. R. 14 E.
12 miles S/W of B.S.L.
(distance) (direction) (nearest town)

WELL PURPOSE: Home
(home, irrigation, municipal, industrial)

- WELL COMPLETION DATA:
- (1) diameter (inches) 2
 - (2) total depth (feet) 310
 - (3) static water level (feet) 10 below above top of ground.
 - (4) casing PVC, 300,
(material) (depth)
(size) if telescope see back.
 - (5) screen 10', -
(length) (depth to top)
2", PVC
(size) (material)
 - (6) pump owner
(HP) (yield gpm)
(type power)
 - (7) electric log NO
(yes or no)
N/A
(organization running log)
 - (8) how well bottom plugged BWU

DEPT. OF NATURAL RESOURCES
BUREAU OF LAND & WATER RESOURCES


NOV 22 1982

RECEIVED

DRILLERS REMARKS: N/A

If well telescopes please sketch and show depths.

GROUND LEVEL

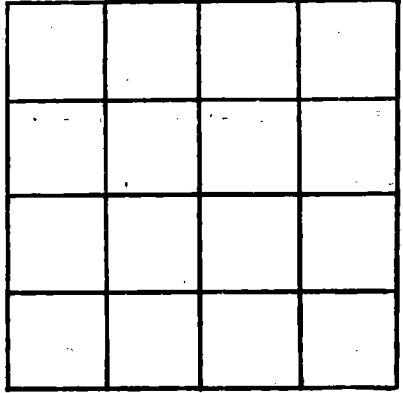

SECTION 8

Please indicate well location X.

ADDITIONAL INFORMATION

If more than one screen,
show locations of each on sketch.