

MISSISSIPPI DEPARTMENT OF NATURAL RESOURCES

Bureau of Land and Water Resources

Southport Mall

P.O. Box 10631

Jackson, Mississippi 39209

WATER WELL DRILLERS LOG

Hancock
K2398

10-8 1982 Ward Well Dly. Hancock
date well completed firm name county well located

LANDOWNER: Ken Vinney
Manhattan St.
Bay St. Louis, ms.
(mailing address)

description of formations encountered	from	to
	<u>Top Soil - clay</u>	<u>0</u>
<u>sd</u>	<u>16</u>	<u>47</u>
<u>Clay</u>	<u>47</u>	<u>105</u>
<u>Subst sd</u>	<u>105</u>	<u>122</u>
<u>Clay - silt</u>	<u>122</u>	<u>152</u>
<u>sd</u>	<u>152</u>	<u>165</u>

WELL LOCATION:
sec. 29 T. 6 N. R. 13 E. 14 W.
12 miles N of Harvard
(distance) (direction) (nearest town)

WELL PURPOSE: camp
(home, irrigation, municipal, industrial)

- WELL COMPLETION DATA:
- (1) diameter (inches) 2"
 - (2) total depth (feet) 165
 - (3) static water level (feet) 4 ^{below} top of ground _{above}
 - (4) casing PVC, 155
(material) (depth)
 If telescope see back.
(size)
 - (5) screen 10'
(length) (depth to top)
2" PVC
(size) (material)
 - (6) pump winer
(HP) (yield gpm)

(type power)
 - (7) electric log NO
(yes or no)
N/A
(organization running log)
 - (8) how well bottom plugged BWV

DRILLERS REMARKS: N/A


DEPT. OF NATURAL RESOURCES
BUREAU OF LAND & WATER RESOURCES

NOV 22 1982

RECEIVED

If well telescopes please sketch and show depths.

GROUND LEVEL

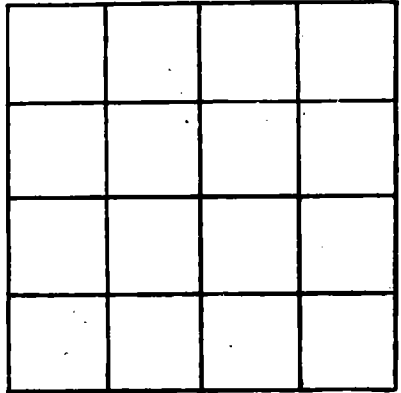

SECTION 39

Please indicate well location X.

ADDITIONAL INFORMATION

If more than one screen, show locations of each on sketch.