

MISSISSIPPI DEPARTMENT OF NATURAL RESOURCES

Bureau of Land and Water Resources

Southport Mall

P.O. Box 10631

Jackson, Mississippi 39209

WATER WELL DRILLERS LOG

Hancock
K 2379

11-24 1982
 date well completed

Ward Well Dr.
 firm name

Hancock
 county well located

LANDOWNER: Alvin Carr
Moran Rd.
Bay St. Louis, ms.
 (mailing address)

description of formations encountered	from	to
	<u>top soil - clay</u>	<u>0</u>
<u>sd</u>	<u>15</u>	<u>82</u>
<u>clay</u>	<u>82</u>	<u>95</u>
<u>sd</u>	<u>95</u>	<u>115</u>
<u>clay</u>	<u>115</u>	<u>136</u>
<u>Red gravel - sd</u>	<u>136</u>	<u>165</u>

WELL LOCATION:
 sec. 31 T. 8 N R. 14 E
~~3~~ miles W of Warland
 (distance) (direction) (nearest town)

WELL PURPOSE: None
 (home, irrigation, municipal, industrial)

WELL COMPLETION DATA:

(1) diameter (inches) 2"

(2) total depth (feet) 165

(3) static water level (feet) 10 ^{below}/_{above} top of ground.

(4) casing PVC, 155
 (material) (depth)
- (size) if telescope see back.

(5) screen 10', -
 (length) (depth to top)
2", PVC
 (size) (material)

(6) pump owner
 (HP) (yield gpm)
- (type power)

(7) electric log NO
 (yes or no)
N/A
 (organization running log)

(8) how well bottom plugged BWU

DRILLERS REMARKS: N/A


DEPT. OF NATURAL RESOURCES
 BUREAU OF LAND & WATER RESOURCES

JAN -7 1983

RECEIVED

If well telescopes please
sketch and show depths.

GROUND LEVEL

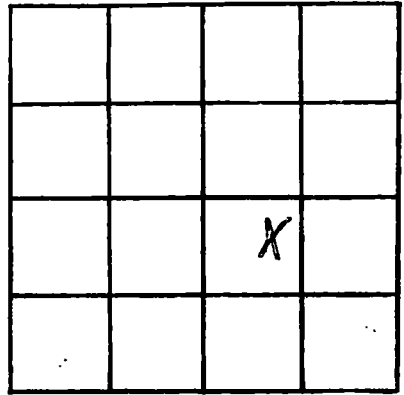

SECTION 31

Please indicate well location X.

ADDITIONAL INFORMATION

If more than one screen,
show locations of each on sketch.