

MISSISSIPPI DEPARTMENT OF NATURAL RESOURCES

Bureau of Land and Water Resources

Southport Mall

P.O. Box 10631

Jackson, Mississippi 39209

WATER WELL DRILLERS LOG

HANCOCK
K 2386
9-81

Sept 1981 Numero Well Drilling Hancock
 date well completed firm name county well located

LANDOWNER: Timothy Hroom
204 Carliss Court
Bay St. Louis
 (mailing address)

description of formations encountered	from	to
clay	0	20
sand & gravel	20	120
Blue clay	120	155
fine sand	155	165
Coarse Sand	165	180

WELL LOCATION:
 sec. 24 T. 8 N. R. 14 E.
5 miles N. of Waveland
 (distance) (direction) (nearest town)

WELL PURPOSE: Home
 (home, irrigation, municipal, industrial)

WELL COMPLETION DATA:
 (1) diameter (inches) 2"
 (2) total depth (feet) 180 ft.
 (3) static water level (feet) 35 below above top of ground.
 (4) casing PVC 170'
 (material) (depth)
 (size) if telescope see back.
 (5) screen 10' 170'
 (length) (depth to top)
2" PVC
 (size) (material)
 (6) pump 1 8
 (HP) (yield gpm)
electric
 (type power)
 (7) electric log
 (yes or no)


(organization running log)
 (8) how well bottom plugged Sand

DRILLERS REMARKS:

DEPT. OF NATURAL RESOURCES
 BUREAU OF LAND & WATER RESOURCES
 OCT 19 1981
RECEIVED

If well telescopes please sketch and show depths.

GROUND LEVEL

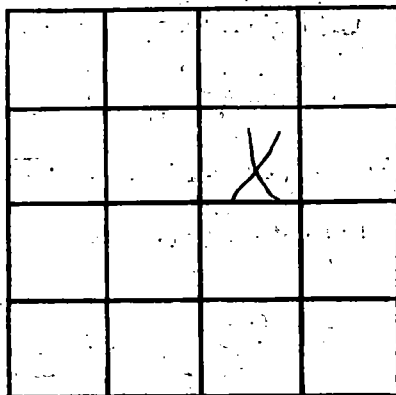

SECTION 24

Please indicate well location X.

ADDITIONAL INFORMATION

If more than one screen, show locations of each on sketch.