

HANCOCK
K 2387
9-22-81

MISSISSIPPI
 BOARD OF WATER COMMISSIONERS
 416 North State Street
 Jackson, Mississippi 39201

WATER WELL DRILLERS LOG

9-22- 1981 Wood Well Dly. Hancock
 date well completed firm name county well located

| LANDOWNER: <u>Tommy Moran</u> <u>pt. 2</u> | description of formations encountered | from | to |
|--|---------------------------------------|------------|------------|
| <u>Bay St. Louis ms.</u> (mailing address) | <u>Clay</u> | <u>0</u> | <u>18</u> |
| WELL LOCATION: <u>sec. 7 T. 98 N. R. 14 E.</u> <u>13</u> miles <u>W</u> of <u>B.S.L.</u> (distance) (direction) (nearest town) | <u>Clay - Sd</u> | <u>18</u> | <u>42</u> |
| WELL PURPOSE: <u>Home</u> (home, irrigation, municipal, industrial) | <u>Clay - silt</u> | <u>42</u> | <u>95</u> |
| WELL COMPLETION DATA: (1) diameter (inches) <u>2"</u> | <u>Red Shale - Sd</u> | <u>95</u> | <u>118</u> |
| (2) total depth (feet) <u>315</u> | <u>Clay - Silt</u> | <u>118</u> | <u>265</u> |
| (3) static water level (feet) <u>10</u> <u>below</u> top of ground. | <u>Sd - Red Shale</u> | <u>265</u> | <u>315</u> |
| (4) casing <u>PVC</u> , <u>305</u> (material) (depth) | | | |
| (5) screen <u>10'</u> , <u>2"</u> (length) (depth to top) (size) | | | |
| (6) pump <u>1</u> , <u>30</u> (HP) (yield gpm) | | | |
| (7) electric log <u>no</u> (yes or no) | | | |
| (8) how well bottom plugged <u>N/A</u> | | | |
| DRILLERS REMARKS: <u>Installed</u> <u>pump.</u> | | | |


Rec'd 10-21-81

If well telescopes please sketch and show depths.

GROUND LEVEL

120'
4" PVC

10'
S.S. - 8 Slot Screen
185' - PVC

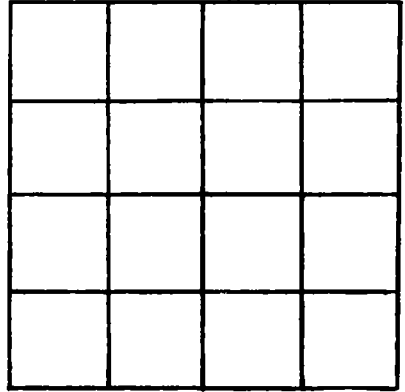

SECTION _____

Please indicate well location X.

ADDITIONAL INFORMATION

If more than one screen, show locations of each on sketch.