

MISSISSIPPI DEPARTMENT OF NATURAL RESOURCES
Bureau of Land and Water Resources
 Southport Mall
 P.O. Box 10631
 Jackson, Mississippi 39209
WATER WELL DRILLERS LOG

Hancock
K 2400

Feb 24 1982 date well completed Cochran Brothers Drilling firm name Hancock county well located

LANDOWNER:	description of formations encountered	from	to
<u>Clarence Dackhilde</u>	<u>Top soil</u>	<u>0</u>	<u>2</u>
<u>405 Hickberry Rd.</u>	<u>Shay clay</u>	<u>2</u>	<u>8</u>
(mailing address)	<u>sand</u>	<u>8</u>	<u>63</u>
WELL LOCATION:	<u>Blue clay</u>	<u>63</u>	<u>148</u>
sec <u>28 T 9 S</u> R <u>14 E</u>	<u>sand</u>	<u>148</u>	<u>190</u>
<u>2</u> miles <u>NW</u> of <u>Waveland</u>			
(distance) (direction) (nearest town)			
WELL PURPOSE: <u>Home</u> (irrigation, municipal, industrial)			
WELL COMPLETION DATA:			
(1) diameter (inches) <u>2"</u>			
(2) total depth (feet) <u>190'</u>			
(3) static water level (feet) <u>2</u> <u>below</u> top of ground.			
(4) casing <u>PVC</u> , <u>180'</u>			
(material) (depth)			
(size) if telescope see back.			
(5) screen <u>10'</u> , <u>180'</u>			
(length) (depth to top)			
(size) <u>2"</u> , <u>PVC</u>			
(material)			
(6) pump _____ (HP) _____ (yield gpm)			
(type power)			
(7) electric log _____ (yes or no)			
(organization running log)			
(8) how well bottom plugged <u>value</u>			
DRILLERS REMARKS:			


DEPT. OF NATURAL RESOURCES
 BUREAU OF LAND & WATER RESOURCES

APR 6 1982

RECEIVED

If well telescopes please sketch and show depths.

GROUND LEVEL

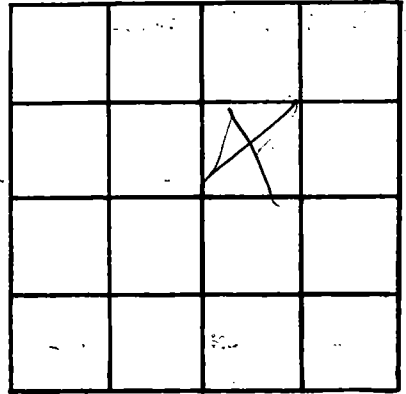

SECTION 28

Please indicate well location X.

ADDITIONAL INFORMATION

If more than one screen, show locations of each on sketch.