

MISSISSIPPI DEPARTMENT OF NATURAL RESOURCES
Bureau of Land and Water Resources
Southport Mall
P.O. Box 10631
Jackson, Mississippi 39209
WATER WELL DRILLERS LOG

Hancock
K 2401

July 25 1982 date well completed Cochran Brothers Drilling Inc firm name Hancock county well located

LANDOWNER: Frank Landee
104 Kamont St
Waveland, Miss
(mailing address)

description of formations encountered	from	to
<u>TOP soil</u>	<u>0</u>	<u>1</u>
<u>Brn clay</u>	<u>1</u>	<u>5</u>
<u>Brn clay</u>	<u>5</u>	<u>10</u>
<u>Sand</u>	<u>10</u>	<u>35</u>
<u>Blue clay</u>	<u>35</u>	<u>52</u>
<u>Sand</u>	<u>52</u>	<u>75</u>

WELL LOCATION:
sec. 38 T. 9 N. R. 14 E 314
3 miles NW of waveland
(distance) (direction) (nearest town)

WELL PURPOSE:
(Home) Irrigation, municipal, industrial

- WELL COMPLETION DATA:
- (1) diameter (inches) 2"
 - (2) total depth (feet) 751
 - (3) static water level (feet) 4' ~~above~~ below top of ground.
 - (4) casing PVC 70'
(material) (depth)
(size) if telescope see back.
 - (5) screen 5' 70'
(length) (depth to top)
2" PVC
(size) (material)
 - (6) pump ~~2~~ ~~HP~~ 700 gpm
(HP) (yield gpm)
(type power)
 - (7) electric log no
(yes or no)
(organization running log)
 - (8) how well bottom plugged Value

DEPT. OF NATURAL RESOURCES
BUREAU OF LAND & WATER RESOURCES


APR 6 1982

RECEIVED

DRILLERS REMARKS: _____

If well telescopes please sketch and show depths.

GROUND LEVEL

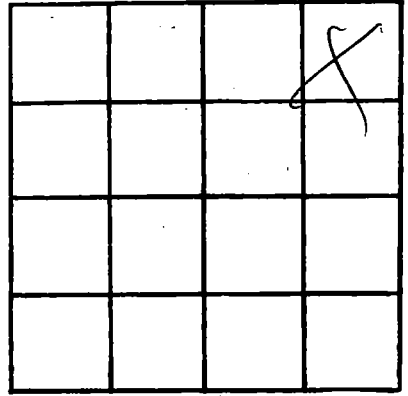

SECTION 30

Please indicate well location X.

ADDITIONAL INFORMATION

Lined area for additional information.

If more than one screen, show locations of each on sketch.